

GOVERNMENT CORNER RESTORATION FORM

FILED

TOWNSHIP 24S RANGE 3W SEC. 15 PLSS # 460440

Date: 2/28/2023 By: X
This survey consists of:

DOUGLAS COUNTY OREGON

DATE 2-15-23

Map: _____
Narrative: _____
Corner Rpt: CS 67/55-41

DOUGLAS COUNTY
SURVEYOR

Corner Designation

C-E 1/4 S15

Monument(s) Found: (Condition and Source)

3'14" BLM BRASS CAP
ON IRON PIPE UP 4"

- Condition report
- Not Found
- Renewed
- Unrecorded
- Surveyed In

Previous Renewals

Set By BLM 1984
Vol 47 pg 17898 & 9

MONUMENT DETAIL

C E 1/4 C
S 15
1984

Accessories Found

BURNED DEAD 33" R. CEDAR N 70 1/2 E
11.9 FT BLAZE - SCAR BURNED OFF ADD
3 1/2" MAG NAIL RIGHT SIDE CENTER

BURNED DEAD 37" D. FIR S 38 1/2 W 15.8 FT
FULLY HEALED SINGLE BLAZE ADD 3 1/2" MAG
NAIL RIGHT SIDE CENTER

NEW TAGS ADDED TO TREES

C.S. File 67/55-41

RENEWAL

Monument Set (Procedure and Description)

MONUMENT DETAIL

New Accessories

Sketch of Monument, Accessories, and General Area


Location & Comments

OCRS COORDINATE SYSTEM
Cottage Grove - Canyonville
Zone
N 173157.239
E 243488.976

MONUMENT ON NORTH
EDGE OF BENCH
APPROX 100' SOUTH
OF STREAM

AREA BURNT
9/2020

Comp. Decline. 14 1/2° E
Agency DC 50
Party Chief S. FLAUSE
Note keeper
Witnesses J. LORSUNG

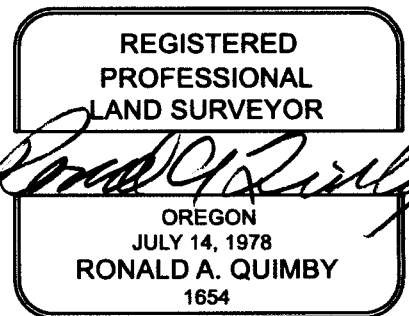

EXPIRES: 12/31/2024

CS 67/55-41
2/4

County Surveyor's Record, Douglas County, Oregon

17898

Subdivision of Section 15, T. 26 S., R. 3 W.,
Willamette Meridian, Oregon

CHAINS

from which bearing trees mkd. by A. R. Evans, Registered Engineer No. 2741, in 1951

A fir, 17 ins. diam., bears S. 1° W., 26 lks. dist., with healed double blaze.

A fir, 25 ins. diam., bears N. 67° W., 24 lks. dist., with healed double blaze.

From this point, Douglas County Surveyor's Office Horizontal Control Station "SWIFTWATER 1978", bears N. 55° 15' E., 171.63 chs, dist., monumented with a brass tablet, 3 ins. diam., set in drill hole, in concrete guardrail on Swiftwater Bridge, with top mkd. DOUGLAS COUNTY SURVEYORS OFFICE SWIFTWATER 1978.

From the ¼ sec. cor. of secs. 14 and 15, monumented with an iron post, 2½ ins. diam., firmly set, projecting 4 ins. above ground, with brass cap missing, from which the remains of bearing trees mkd. by White, Beck, and Reynolds:

A cedar stump, 28 ins. diam., bears N. 20½° E., 60 lks. dist., with scribe marks ¼ S14 BT on partially healed blaze.

A cedar, 23 ins. diam., bears N. 75° W., 29 lks. dist., with; healed blaze.

At the corner point.

Set an iron post, 30 ins. long, 2½ ins. diam., with plastic magnetic breakaway base, 24 ins. in the ground, with brass cap mkd.

T 26 S R 3 W

¼

S 15 | S 14

1984

from which a new bearing tree

A pine, 8 ins. diam., bears S. 26° E., 41 lks. dist., mkd. ¼ S14 BT.

Deposit 1962 iron post alongside new iron post.

N. 89° 47' W., on the E. and W. center line of sec. 15.

Descend over W. slope.

4.15 Britt Creek, 10 lks. wide, course N. 5° E.; asc. over broken NE. slope.

17.05 Gravelled road, 20 lks. wide, bears N. 5° W. and S. 15° E.

20.06 Point for the center E 1/16 sec. cor. of sec. 15.

Set an iron post, 30 ins. long, 2½ ins. diam., with plastic magnetic breakaway base, 22 ins. in the ground, with brass cap mkd.

3¼" B.C.

E 1/16 C ✓

S 15

1984

PROT. 4"

ORCS CANYONVILLE COORDS

173157.239 N, 243488.976 E

FOUND OK
2/15/23

CS 67/55-41/3/4

OVER →

County Surveyor's Record, Douglas County, Oregon

Subdivision of Section 15, T. 26 S., R. 3 W., **17899**
Willamette Meridian, Oregon

FOUND OK 2/15/23

CHAINS

BURNED DEAD 33"
BURNED DEAD 37"
DEC. 14 1/2 E

from which

A cedar, ~~26~~ ins. diam., bears N. 70 1/2° E.,
18 lks. dist., mkd. CE 1/16 S15 BT.

ADD NEW TAGS & FLAGGING

11 88 A fir, 25 ins. diam., bears S. 38 1/2° W.,
24 lks. dist., mkd. CE 1/16 S15 BT.

BLZ, SCARBUR - NED OFF

15 84

FHSB

Ascend over broken NE slope. **MONUMENT ON NORTH EDGE OF BENCH APPROX. 100 FT. SOUTH OF STREAM**

26.10

Spur, slopes N. 30° E.; desc. over NW. slope.

28.30

Gravelled road, 20 lks. wide, bears N. 10° E. and S. 25° W.

40.12

The center 1/4 sec. cor. of sec. 15.

Descend over NW. slope.

44.00

Creek, 5 lks. wide, course N. 10° E.; asc. over E. slope.

57.15

Gravelled road, 15 lks. wide, bears N. 30° E. and S. 30° W.

60.23

Point for the center W 1/16 sec. cor. of sec. 15.

Set an iron post, 28 ins. long, 2 1/2 ins. diam., 25 ins. in the ground, with brass cap mkd.

W 1/16 C
S 15
1984

from which

A fir, 5 ins. diam., bears S. 81 1/2° E., 22 lks. dist., mkd. CW 1/16 S15 BT.

A fir, 9 ins. diam., bears N. 37 1/2° W., 26 lks. dist., mkd. CW 1/16 BT.

Ascend over E. slope.

80.34

The 1/4 sec. cor. of secs. 15 and 16, monumented with an iron post, 2 1/2 ins. diam., firmly set, projecting 4 ins. above ground with brass cap mkd.

T 26 S R 3 W
1/4
S 16 | S 15
1962

from which bearing trees mkd. by White, Beck, and Reynolds

A cedar, 15 ins. diam., bears S. 84° E. 69 lks. dist., with healed blaze.

A cedar, 14 ins. diam., bears N. 71° W., 48 lks. dist., with healed blaze.

From the center E 1/16 sec. cor. of sec. 15. N. 1° 48' W., on the N. and S. center line of the NE 1/4 of sec. 15. Descend over N. slope, through heavy timber and dense undergrowth.

CS 67/55-41
4/4