

GOVERNMENT CORNER RESTORATION FORM

FILED

TOWNSHIP 24S RANGE 3W SEC. 15 PLSS # 460960

Date: 2/28/2023 By: JC

This survey consists of:

Map: _____

Narrative: _____

Corner Rpt: CS 67/55-42

DOUGLAS COUNTY OREGON

DATE 2-15-23

DOUGLAS COUNTY
SURVEYOR

Corner Designation

NE 1/16 S15

Monument(s) Found: (Condition and Source)

3'14" BLM BRASS CAP ON
Iron Pipe up 1"

___ Condition report

___ Not Found

Renewed

___ Unrecorded

___ Surveyed In

Previous Renewals

BLM 1984 set monument
Vol 47 pg 17900

MONUMENT DETAIL

NE 1/16
S15
1984

Accessories Found

BURDED SAWN 15" X 3' D. FIRE STUMP
N84°E 8.5 FT Healed Low BLAZE ADD
3 1/2" MAG Nail Top Center

8" I. CEDAR Singed BASE S19 1/2° W 21.1 FT
Fully Healed Low BLAZE

C.S. File 67/55-42

Monument Set (Procedure and Description)

MONUMENT DETAIL

New Accessories

Sketch of Monument, Accessories, and General Area


Location & Comments

OCRS Coordinates
 Cottage Grove, Canyonville
 Zone

N 174499.696
 E 243441.028

AREA BURNT
 9/2020
 Monument on
 Westerly Edge of
 Large Bench Running
 North & South 14 1/2° E
 Comp. Decline
 Agency DCSO
 Party Chief S. FIAUSE
 Note keeper
 Witnesses J. LORSUNG

CS 67/55-42
 2/3

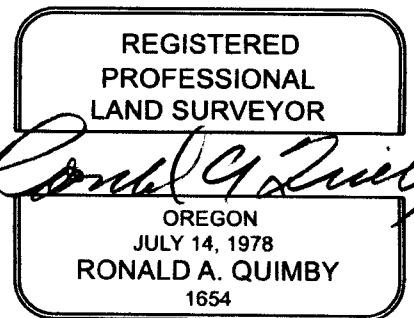

EXPIRES: 12/31/2024

County Surveyor's Record, Douglas County, Oregon

17900

Subdivision of Section 15, T. 26 S., R. 3 W.,
Willamette Meridian, Oregon

CHAINS

- 1.80 Ravine, drains N. 20° E.; asc. over SE. slope.
- 4.95 Spur, slopes N. 70° E.; desc. over NE. slope.
- 6.50 Gravelled road, 20 lks. wide, bears N. 40° W. and S. 40° E.
- 11.05 Creek, 4 lks. wide, course N. 40° E.; desc. over nearly level land.
- 11.45 Same creek, 4 lks. wide, course N. 65° W.; desc. over nearly level land.
- 11.95 Same creek, 4 lks. wide, course N. 30° E.; desc over NW. slope.
- 15.90 Gravelled road, 20 lks. wide, bears N. 45° W. and S. 45° E.
- 20.39 Point for the NE 1/16 sec. cor. of sec. 15, at intersection with the E. and W. center line of the NE 1/4 of sec. 15.

Set an iron post, 28 ins. long, 2 1/2 ins. diam., 24 ins. in the ground, with grass cap mkd.

RENEWED 2/15/23

T26S, R03W, 460460

3 1/4" BC

NE 1/16
S 15
1984

PROT 1"
from which

85

BURNED SAWN 15" x 3 FT STUMP

A fir, *Line* diam., bears N. 84° E., 13 lks. dist., mkd. NE 1/16 S15 BT.

ADD 3 1/2" MAG NAIL TOP CNTR.

SINGED BASE ALIVE 8"

A cedar, 4 ins. diam., bears S. 19 1/2° W., 32 lks. dist., mkd. X BT.

HEALED LOW BLZ, FULLY HEALED HIGH LOW BLZ.

Descend over NW. slope.

28.85

Dirt road, 15 lks. wide, bears N. 70° E. and W.

DECLINATION 14 1/2° E

40.78

The E 1/16 sec. cor. of secs. 10 and 15, monumented with an iron post, 2 1/2 ins. diam., firmly set, projecting 4 ins. above ground, with brass cap mkd.

S 10
E 1/16 S 15
1962

from which bearing trees mkd. by White, Beck, and Reynolds

A fir, 8 ins. diam., bears N. 51 1/2° E., 17 lks. dist., with healed blaze.

A fir, 14 ins. diam., bears S. 82° W., 6 lks. dist., with healed blaze.

From this point, an iron pipe, 3/4 in. diam., firmly set, projecting 2 ins. above ground, bears N. 51 1/2° W., 0.045 chs. dist.

NE 1/16 S15

*OCT 18 1985
OACS CANYONVILLE COORDS*

174499.696 N, 243441.028 E

**MONUMENT ON WESTERLY EDGE OF
LARGE BENCH RUNNING NORTH AND SOUTH**

CS 67/55-42

3/3