

GOVERNMENT CORNER RESTORATION FORM

FILED

TOWNSHIP 265 RANGE 3W SEC. 26 PLSS # 54026

Date: 3-16-2023 By: XC

This survey consists of:

Map: \_\_\_\_\_

DOUGLAS COUNTY OREGON

DATE 2-1-23

Narrative: \_\_\_\_\_

Corner Rpt: CS 67/55-43

Corner Designation

CN 1/16 526

DOUGLAS COUNTY  
SURVEYOR

Monument(s) Found: (Condition and Source)

None - BC position now falls in  
East shoulder of rebuilt and now gravelled  
RD. BC search for not found

Condition report

Not Found

Renewed

Unrecorded

Surveyed In

Previous Renewals

Corner set by BLM Vol <sup>37</sup>  
1972 Destroyed by ROAD P15406-7  
Construction

MONUMENT DETAIL

BLM Renewal Vol 55  
Pg 22710

Accessories Found

Badly Burnt SAWN 26" X 5' TALL D. FIR STUMP  
S2°E 32.3 FT with healed BLAZE ADD 3 1/2"

MAG NAIL TOP CENTER

Badly Burnt SAWN 23" X 4 1/2' D. FIR STUMP  
N15°14'W 33.0" Healed BLAZE ADD 3 1/2"

MAG NAIL TOP CENTER

C.S. File 67/55-43

RENEWAL

Monument Set (Procedure and Description)

MONUMENT DETAIL

5/8" x 30" I. ROD with DCSO  
PLASTIC CAP AT REFERENCED  
COR POSITION FROM  
BEARING TREES UP 2" IN  
ROUGH MOUND OF STONE

New Accessories

Sketch of Monument, Accessories, and General Area

Location & Comments

LAT 43°16'56.72"N  
LONG 123°01'11.87"W

CORNER IS IN EAST  
SHOULDER OF GRAVEL  
ROAD

AREA BURNT  
9/2020


Comp. Decline. 14 1/2° E

Agency DCSO

Party Chief S. FIAUSE

Note keeper

Witnesses J LORSUNG

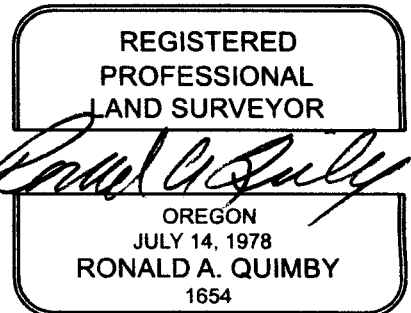

EXPIRES: 12/31/2024

CS 67/SS-43

213

MM 05 2/1/23

RENEWED 2/1/23

TIME - 12:00

H.I. - 2.000M 20/55

22710

2009

Dependent Resurvey of a Portion of the  
Subdivision of Section Lines in Section 26,  
T. 26 S., R. 3 W., Willamette Meridian, Oregon

PLSS 540260

The center N 1/16 sec. cor. of sec. 26, monumented with an iron post, 2 1/2 ins. diam., firmly set, buried 5 ins. below the ground, with brass cap mkd.

DECLINATION  $14\frac{1}{2}^{\circ}E$

N 1/16 | S 26  
C  
C  
1972

BC. POSITION NOW FALLS IN  
EAST SHOULDER OF REBUILT AND  
NOW GRAVELLED RD.

BRASS CAP SEARCHED FOR NOT FOUND.

SET  $5/8" \times 30"$  I.R. / DCSO PLATE CAP  
SET AT REFERENCED

from which bearing trees mkd. by Berry, Popken, and Carlson in 1972-75

BADLY BURNED SAWN STUMP, D. FIR  
2.6" X 5 FT TALL

A fir, 23 ins. diam., bears S.  $2^{\circ}E$ , 32.3 ft. dist., with a healed blaze.

COR. POSITION  
NOW PROT 2 IN. AND  
IS INSIDE  
ROUGH  
MOUND OF  
STONE

BADLY BURNED SAWN STUMP, D. FIR  
23" X 4 1/2 FT. TALL

A fir, 19 ins. diam., bears N.  $15\frac{1}{4}^{\circ}W$ , 33.0 ft. dist., with a healed blaze. (Record N.  $12^{\circ}W$ .)

E

Corner is located on the N. edge of a dirt road, 12 ft. wide, bears N.  $30^{\circ}E$  and S.  $30^{\circ}W$ .

CS 67/55-43