

GOVERNMENT CORNER RESTORATION FORM

FILED

TOWNSHIP 24S RANGE 3W SEC. 26 PLSS # 520240

Date: 3/16/2023 By: X
This survey consists of:

DOUGLAS COUNTY OREGON

DATE 2-2-23

Map: _____
Narrative: _____
Corner Rpt: CS 67/55-44

DOUGLAS COUNTY
SURVEYOR

Corner Designation

CW 1/16 S 26

Monument(s) Found: (Condition and Source)

3/4" BLM BRASS CAP
up 9"

- Condition report
- Not Found
- Renewed
- Unrecorded
- Surveyed In

Previous Renewals

Set by BLM 1972
Vol 37 pg 15408
Geisler BL CS 63/34

MONUMENT DETAIL

C W 1/16 C
S 26
1972

Accessories Found

BURD + SAWN 25" x 2' D. FIR STUMP
S 45° E 23.2 FT (REC 23.1 FT) ADD 3 1/2" W/AG
NAIL TOP CENTER FULLY HEATED SINGLE BLAZE

RENEWAL

Monument Set (Procedure and Description)

MONUMENT DETAIL

New Accessories

Singed - SAWN 2" X 2' D. Fir Stump
N 71° E 7.3 FT 3 1/2" MAG Nail Top Center

Sketch of Monument, Accessories, and General Area

Location & Comments

LAT 43° 16' 43.68" N
LONG 123° 01' 29.74" W

CORNER ON moderate
S.W. slope IN
Clear Cut

AREA BURNED
9/2020


Comp. Decline. 14 1/2° E

Agency DCEO

Party Chief S. F. HUSE

Note keeper

Witnesses J. LORSUNG

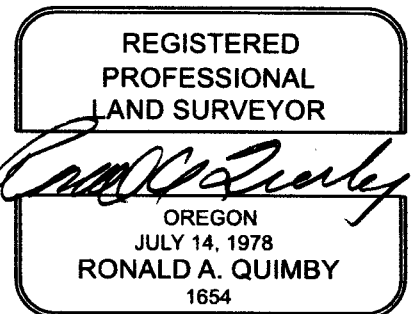

EXPIRES: 12/31/2024

CS 67/55 - 44
213

County Surveyor's Record, Douglas County, Oregon

MM GPS 2/2/23

TIME - 11:50

H.L. - 2:00 PM

RENEWED

15408

2/2/23

Subdivision of Section 26,
T. 26 S, R. 3 W., Willamette Meridian, Oregon

CHAINS

57.20

Spur, ridge, bears N. and S.; desc. 45 ft. over SW. slope.

60.43

Point for the center W 1/16 sec. cor. of sec. 26.

Set an iron post, 28 ins. long, 2 1/2 ins. diam., 24 ins. in the ground, with brass cap mkd.

DECLINATION 14 1/2° E

W 1/16 S 26 C 1972

3 1/4" B.C. PROT. 9"

from which

~~GONE~~ A fir, 20 ins. diam., bears N 10° W 43 lks. dist., mkd. CW 1/16 S26 BT.

NO EVID. REMAINS BURNED SAWN STUMP 28" x 2 FT. TALL

A fir, 11 ins. diam., bears S. 45° E., 35 lks. dist., mkd. CW 1/16 S26 BT.

28 38
F.D. OR 4/10/66
R.C. S. 63/137
(28" FIR, NEW STUMP)

ADD 3 1/2" MAGNAIL TOP CENTER

23 2
FHSB FACE IN STUMP

Descend 180 ft. over SW. slope.

74.90

Creek, 3 lks. wide, course S. 10° W.; asc. 40 ft. over SE. slope.

NEW REF. SINGED SAWN D. FIR STUMP 21" x 2 FT TALL

80.58

The 1/4 sec. cor. of secs. 26 and 27.

21" x 2 FT TALL N 71° E, 73 FT 3 1/2" MAGNAIL TOP CNTR

From the center E 1/16 sec. cor. of sec. 26.

N: 0° 11' W., on the N. and S. center line to the NE 1/4 of sec. 26.

CORNER ON MODERATE SW SLOPE IN

Ascend 25 ft. over SW. slope, through heavy timber and dense undergrowth.

RECENT CLEAR CUT

3.00

Spur, slopes W.; desc. 95 ft. over NW. slope.

12.10

Ravine, drains S. 40° W.; asc. 85 ft. over SW. slope.

19.99

Point for the NE 1/16 sec. cor. of sec. 26, at intersection with the E. and W. center line of the NE 1/4 of sec. 26.

Set an iron post, 28 ins. long, 2 1/2 ins. diam., 22 ins. in the ground, with brass cap mkd.

NE 1/16 S26 1972

from which

A fir, 11 ins. diam., bears N. 73° E., 57 lks. dist., mkd. NE 1/16 S26 BT.

A fir, 10 ins. diam., bears S. 55° E., 73 lks. dist., mkd. NE 1/16 S26 BT.

No other suitable bearing trees available within limits.

Ascend 15 ft. over SW. slope.

21.45

Spur, slopes W.; desc. 125 ft. over NW slope.

29.50

Ravine, drains N. 75° W.; asc. 35 ft. over SW. slope

CS 67/55-44