

GOVERNMENT CORNER RESTORATION FORM

FILED

TOWNSHIP 255 RANGE 3W SEC. 36 PLSS # 640100

Date: 3/16/2023 By: X
This survey consists of:

DOUGLAS COUNTY OREGON

DATE 3-1-23

Map: _____
Narrative: _____
Corner Rpt: CS 67/55-47

Corner Designation

$\frac{1}{4}$ COR $\frac{36}{1}$ T255
T265

DOUGLAS COUNTY
SURVEYOR

Monument(s) Found: (Condition and Source)

___ Condition report

3/4" BLM BRASS CAP ON

___ Not Found

2" I D Iron Pipe

Renewed

UP 8" 2" I. Pipe WNW 0.4' up 10"

___ Unrecorded

Previous Renewals

___ Surveyed In

BLM Resurvey 1940 Vol 27 pg 11507-08

Hosford 1960 CS 51/161

MONUMENT DETAIL

BLM Resurvey 1962-1963 Vol 32 pg 13374

T255

WARE 1982 M 93-26 A & B

R3W

De Groot 1994 M 120-3

$\frac{1}{4}$ S36

EDWARDS 1998 M 128-61

S1

Schinnell 2006 M 149-35

T265

DCSO 2008 CS 67/25-16 & 19

1963

Accessories Found

SAWN BURNED 38" X 3 FT Hemlock Stump N57 1/2° E
18.2 FT (Rec 18.5 FT) ADD 3 1/2" MAG Nail Top Center

BURNED DEAD 16" D. FIR S4° W 12.2 FT (Rec 12.5 FT)
BLAZE & Notch BURNED ADD 3 1/2" MAG Nail RIGHT
Side Center

BURNED DEAD 10" Hemlock N58° W 14.0 FT
Upper BLAZE BURNED out BLAZE AND Notch
BURNED ADD 3 1/2" MAG Nail RIGHT Side
Center

C.S. File 67/55-47

RENEWAL

Monument Set (Procedure and Description)

MONUMENT DETAIL

New Accessories

Sketch of Monument, Accessories, and General Area

Location & Comments

OCRS Canyonville Cottage
 Grove Coordinate System
 N 186195.478
 E 252525.308

Corner is approx
 140' N30W From
 Residence @ 1244
 Rock Cr. Road

AREA Burnt
 9-2020


Comp. Decline. 14 1/2° E

Agency DCSO

Party Chief S. Fixuse

Note keeper

Witnesses J LORSUDG

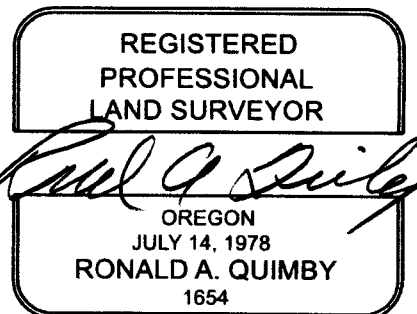

EXPIRES: 12/31/2024

CS 67/55-47 2/4

PRIMARY CORNER DESCRIPTION 1/4 Cor. for Sec. 36: & 1 of T. 26-3

Alias _____	Description _____
Alias _____	Description _____
Alias _____	Description _____
Alias _____	Description _____

At the corner point, set an iron post, 28" long 2 1/2" dia., 22" in the ground with brass cap mkd: T 25 S
R 3 W
1/4 S 36
S 1
T 26 S
1963

from which a new bearing tree:
A Fir 10" dia. bears S.47°E., 103 lks., mkd. 1/4 S1 BT.
Reset iron pipe alongside iron post.

Found OK, Romano Ware, October 1982, M 93-26 A&B
Found OK, Kristian DeGroot, April 1994 - M 120-3.

Fd. Ok by D. Edwards, 4/1998 - M128-61

Kevin Schinnell - For: Rosboro Lumber Co. - 1/2006 - M 149-35

Found - 3/4" brass monument on 3" iron pipe, 0.6' visible & one accessory as follows:
36" fir N.60°E., 17.37'
New - 12" fir S.04°W., 11.95'
8" hemlock N.58°W., 13.68'
Note - All accessories repainted and flagged at this time.

Douglas Co. Surveyors Office - John Pike - Stephen J. Flauser - 2/21/2008 - C.S. File 67/25-16 & 19

Condition report
Found - 3/4" BC on 2" O.D. iron pipe properly marked, projects 8" above ground. A 2" O.D. iron pipe is found beside BC/IP. *PROT 8"*
RENEWED 3/1/23
GONE IN BUILDING SITE now 16" dia., x 2 ft. tall stump, pitch pocket visible on top of stump, bears S.47°E., 66.8 ft. (rec. S.47°E., 68.0 ft.) 1963 BT
SAWN BURNED 38" x 3 FT STUMP now 37" dia., hemlock (not fir as reported by Schinnell in 2006) bears N.57 1/2°E., 18.5 ft. (rec. N.53°E., 17.6 ft.) 1960 BT
BURNED DEAD 16" 12" now 15" fir bears S.4°W., 12.5 ft. to center of root crown. Note: Tree was not scribed is marked with upper blaze painted red, and lower notch w/alum nail. Distances recorded by Schinnell are sloped and are measured to tip of nail. (Rec. S.4°W., *11.95* ft.) 2006 BT
BLAZE & NOTCH BURNED

continued next page

TOWNSHIP 25 RANGE 03 POINT IDENTIFIER # 640100

PRIMARY CORNER DESCRIPTION 1/4 Cor. for Sec. 36; & 1 of T.26-3

Alias _____	Description _____
Alias _____	Description _____
Alias _____	Description _____
Alias _____	Description _____

BURNED DEAD 10" ^{8"}

BURNED OUT

now [✓] Hemlock bears N.58°W., 14.0 [✓] ft. to center of root crown. Note: Tree was not scribe is marked with [✓] upper blaze. Painted red & lower [✓] notch w/alum [✓] nail. Distances recorded by Schinnell are sloped and are measured to tip of nail (Rec. N.58°W., 13.68 ft.) 2006 BT

No new accessories, report was made to describe the condition of 2006 accessories.

Note - Corner is approx. N.30°W., ~~170~~ ¹⁴⁰ ft. from residence to SE (1266 Rock Crk. Rd.)

Compass decl. 16 1/4° E. ^{DECLINATION 14 1/2° E}

ADD 3 1/2 MAG NAIL R.S.C. TO FOUND BT'S

BLAZE & NOTCH BURNED

O CRS CANYONVILLE COTTAGE GROVE COORDS
 186195.478 N 252525.308 E

CS 67/55-47
 4/4