

GOVERNMENT CORNER RESTORATION FORM

TOWNSHIP 26S RANGE 1W SEC. 21 PLSS # 400300

FILED
Date: 3/21/2023 By: XC
This survey consists of:

DOUGLAS COUNTY OREGON

DATE 9-19-22

Map: _____
Narrative: _____
Corner Rpt: CS 67 | 55-55

DOUGLAS COUNTY
SURVEYOR

Corner Designation

SEC COR 2 S21/S22
S28/S27

Monument(s) Found: (Condition and Source)

2 1/2" DC SO BRASS CAP
UP 10"

- Condition report
- Not Found
- Renewed
- Unrecorded
- Surveyed In

Previous Renewals

DC SO 1975 CS 57/34-7

MONUMENT DETAIL

Douglas County
Surveyor
T26S
S21/S22
S28/S27
R1W
1975

Accessories Found

BURNED - SAWN 30" X 2' FIR N23°E 11.5 FT
(REC 11.2 FT ADD 3 1/2" MAG NAIL TOP CENTER
BURNED - BROKEN - SHATTERED 2" TALL STUMP
560°W 23.1 FT.
BURNED - DEAD 27" HEMLOCK N83°W 22.8 FT
(REC 23.8 FT) HEALED SINGLE BLAZE ADD 3 1/2"
MAG NAIL RIGHT SIDE CENTER
BURNED - DEAD 29" HEMLOCK S41°E 109.1 FT
HEALED DOUBLE BLAZE ADD 3 1/2" MAG NAIL
RIGHT SIDE CENTER

C.S. File 67 | 55-55

RENEWAL

Monument Set (Procedure and Description)

MONUMENT DETAIL

New Accessories

BURNED- DEAD 11" Hemlock S76°E 20.2 FT
Not BLAZED or Scribed 3 1/2" MAG NAIL
RIGHT Side Center

BURNED- DEAD 10" Hemlock S22°W 17.4 FT
Not BLAZED or Scribed 3 1/2" MAG NAIL
RIGHT Side Center

Sketch of Monument, Accessories, and General Area

Location & Comments

LONG 122° 48' 54" W
LAT 43° 17' 04" N

MONUMENT IS 80'[±]
SOUTH OF GRAVEL
ROAD

AREA BURNED

9-2020 14 1/2° E


Comp. Decline.

Agency DCSO

Party Chief J. F. RAUSE

Note keeper

Witnesses J. LORSUNA

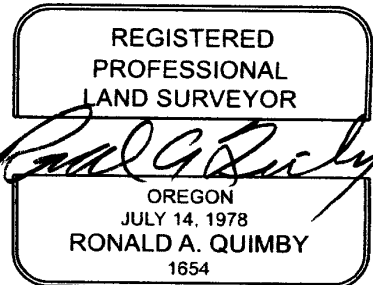

EXPIRES: 12/31/2024

CS 67/55-55 2/3

MMGPS - 8/1/22
TIME - 12:30
H.I. - 2.00CM

9/19/22

TOWNSHIP 26 RANGE 01 POINT IDENTIFIER # 400300

PRIMARY CORNER DESCRIPTION Cor Secs 21, 22, 27 & 28

Alias _____	Description _____
Alias _____	Description _____
Alias _____	Description _____
Alias _____	Description _____

GLO survey by Fred Mensch, Deputy Surveyor - contract #797 dated April 19, 1910 - (DCSO records Vol. 10 Page(s) 4128)

Set a basalt stone 15x10x8", 10" in the ground for cor. of secs. 21, 22, 27, & 28 mkd with 2 notches on S & 3 notches on E edge, from which

- A fir, 20" dia. bears N.23°E. 17 lks. mkd: T26S R1W S22 BT
- A fir, 24" dia. bears S.70°E. 56 lks. mkd: T26S R1W S27 BT
- A fir, 15" dia. bears S.60°W. 35 lks. mkd: T26S R1W S28 BT
- A hemlock, 8" dia., bears N.83°W., 36 lks., mkd: T26S R1W S21 BT.

Douglas Co. Surveyors Office - Gary Langlitz - Clell Goodwin
Eric Cangie - M Lenora Ladig - 7/22/1975 - C.S. File 57/34-7

Found A stone, 10x8x6" (rec. 15x10x8") firmly set, marked with 3 notches on the East edge & 2 notches on the south edge. From which

BURNED SAWN STUMP
BURNED BROKEN SHATTERED
BURNED DEAD 27"

- An Orig. ~~20"~~ now 24" fir bears N.23°E., ^{11.2} 11.2 ft., ^{ADD 3 1/2" NAIL TOP CNTR.} alive & well healed.
- The orig. SE BT has been destroyed by logging.
- An orig. 15" fir, now an 18" snag bears S.60°W., 23.1 ft. with scribe marks visible on a partially healed blaze.
- An orig. ~~8"~~ now 15" hemlock bears N.83°W., ^{22.8} 22.8 ft. ^{ADD 3 1/2" NAIL RSC} alive with scribed marks visible on a partially healed blaze. **FHSB**

At the corner point, we set a 1"x30" IP with brass cap attached mkd:
 DOUGLAS CO SURVEYOR T 26 S ✓
 1975 ✓ S 21 | S 22
 S 28 | S 27
 R 1 W

2 1/2" BC
PROT 10"

We place the orig. corner stone along side the brass cap & mark the following new BT:

- BURNED DEAD 24"** An 8" hemlock bears S.41°E, 109.1 ft. scribed "T26S R1W S27 CS BT" on a double blaze. **FHOB**
- Compass decl. 20°E.

NEW REF

BURNED DEAD 11" HEMLOCK NOT BLZD OR SCR BN 3 1/2" MAG NAIL RSC S76°E, 20² FT

BURNED DEAD 10" " " " " " " S22°W 17⁶ FT

MONUMENT IS ≈ 80 FT. SOUTH OF GRAVEL RD. 1

DECLINATION 14 1/2° E

CS 67/55-SS 3/3.