

GOVERNMENT CORNER RESTORATION FORM

FILED

TOWNSHIP 25S RANGE 3W SEC. 36 PLSS # 700140

Date: 3/21/2023 By: X
This survey consists of:

DOUGLAS COUNTY OREGON

DATE 3-1-23

Map: _____
Narrative: _____
Corner Rpt: CS 67/55-57

DOUGLAS COUNTY
SURVEYOR

Corner Designation

E 1/4 COR SEC 36 ONLY

Monument(s) Found: (Condition and Source)

BLM BRASS CAP UP 13"

- Condition report
- Not Found
- Renewed
- Unrecorded
- Surveyed In

Previous Renewals

GLD Resurvey 1940 Vol 27 pg 11509

DCSD 1966 CS 54/27-171

BLM Resurvey 1972-1975 Vol 36 pg 15110

DCSD 1992 CS 64/32-2

EDWARDS 1998 M 128-61

BLM Resurvey 2018-2020
Vol 59 Pgs 23919-20

MONUMENT DETAIL

1/4 536 |
1943

Accessories Found

BURNED FIR STUB 20" X 1 FT S 46 1/4° W 40.6 FT

NO MARKS VISIBLE

BURNED MADRONE STUB 4" X 1 1/2 FT S 55 1/4° W 3.4 FT

BLAZE BURNED OFF

BURNED DEAD 11" CEDAR N 44 1/2° W 26.9 FT

BLAZE VIS SCRIBES BURNED OFF 2 1/2" MAG

NAIL RIGHT SIDE CENTER

SAWN BURNED 21" X 7 FT D. FIR STUMP S 33 1/4° W

39.3 FT HEALED DOUBLE BLAZE ADD 3 1/2" MAG

NAIL RIGHT SIDE CENTER

RENEWAL

Monument Set (Procedure and Description)

MONUMENT DETAIL

New Accessories

Sketch of Monument, Accessories, and General Area

Location & Comments

Lat $43^{\circ}21'05.89''$ N
 Long $122^{\circ}54'26.04''$ W

ON LARGE BENCH
 Recent Logging To
 West Burnt Forest
 To East

AREA BURNED
 9-2020


Comp. Decline. $14\frac{1}{2}^{\circ}$ E

Agency DCSD

Party Chief S.F. AUSE

Note keeper

Witnesses J. LORSUNG

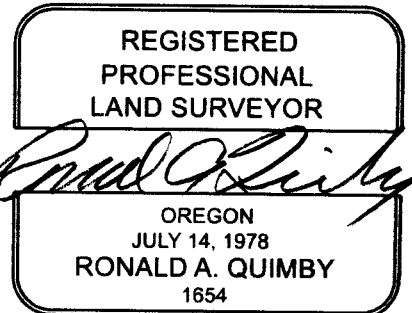

EXPIRES: 12/31/2024

CS 67/55-57

MM GPS 3/1/23
TIME - 9:30
H.I. - 2,000M

RENEWED 3/1/23

TOWNSHIP 25 RANGE 03 POINT IDENTIFIER # 700140

PRIMARY CORNER DESCRIPTION East 1/4 Corner Sec 36 only

Alias _____	Description _____
Alias _____	Description _____
Alias _____	Description _____
Alias _____	Description _____

New BTs- 14" dia. D.Fir double blazed and scribed "¼ S36 CS BT" bears S.2½°W., 39.1 ft.
 12" dia. D.Fir double blazed and scribed "¼ S36 CS BT" bears S.45½°W., 40.5 ft.
 4" dia. Madrone bark scribed "¼ S36 CS BT" bears S.53°W., 3.6 ft.
 14" dia. Alder bark scribed "¼ S36 CS BT" bears N.26½°W., 20.8 ft.

Fd. Ok by D.Edwards, 4/1998 - M128-61

BLM dependent resurvey by Jeffrey O. Covington, Cadastral Surveyor, under Group No. 2919, surveyed May 2018/July 2020 - (DCSO records Vol. 59 Page(s) 23919-20)

The ¼ sec. cor. of sec 36 only T25S R3W perpetuated by Smith, in 1992, monumented with an iron post, 1" dia., firmly set, projecting 13" above ground, with a brass cap (properly) mkd. from which the remains of the BTs mkd. by Price in 1943-44

NO GOOD EVID. ~~GONE~~ A decayed fir stump, 11" dia., bears S.8½°W., 4.6 ft., no marks visible.

NO GOOD EVID. ~~GONE~~ A roothole bears N.38°W., 5.9 ft., alongside of which is a down decayed fir, 10 ins. diam., no marks visible and a broken top.

and the remains of the BTs mkd by the Douglas Co. Surveyors Office in 1966, reported by Berry, Wofford, Popken, and Baughman in 1972-75

NO GOOD EVID. ~~GONE~~ A decayed fir stump, 16" dia., bears S.76°W., 39.6 ft., with a healed blaze

NO GOOD EVIDENCE ~~GONE~~ A decayed hemlock stump, 16" dia., bears N.22°W., 22.4 ft. no marks visible.

and the remains of the bearing trees mkd. by Smith
SAWN BURNED 21" x 7 FT. A fir stump 21" dia., bears S.3¾°W., 39.8 ft., with a healed double blaze

NO BURNED STUB 20" x 1 FT. A decayed fir stump, 17" dia., bears S.46¼°W., 40.6 ft. no marks visible.

BURNED STUB 4" x 1 1/2 FT. A madrone snag, 4" dia., bears S.55¼°W., 3.4 ft., with scribe marks ¼ S36 BT visible on bark. and new bearing trees BLAZE BURNED OFF

BURNED FALLEN KICKED OUT OF POSITION The northerly stem of a twin trunked hemlock, 4" dia., bears S.79¾°W., 43.8 ft. mkd. X BT BLAZES VISIBLE SCRIBG GONE

BURNED DEAD A cedar, 11" dia., bears N.44½°W., 26.9 ft. mkd. ¼ S36 BT BLAZE VIS. SCRIBG GONE
Each new BT has a 2½" x ¼" magnetic nail (Mag Nail) driven at the base right side-center & each monument established or remonumented has a magnet deposited in a white plastic case at the base of the stainless steel post. Alum. Angle iron driven alongside each monument.

DECLINATION 14½° E CS 67/55-57 3/3
ON LARGE BENCH RECENT LOGGING TO WEST BURNED FOREST TO EAST

TOWNSHIP 25 RANGE 03 POINT IDENTIFIER # 700140

PRIMARY CORNER DESCRIPTION East 1/4 Corner Sec 36 only

Alias _____	Description _____
Alias _____	Description _____
Alias _____	Description _____
Alias _____	Description _____

(Original 1/4 Corner for 36 and 31 of T.25-2 set by Laban Wheeler, Contract #467, 1883) DCSO records, Volume 9 Pg 3585

GLO Dependent Resurvey by Norman D. Price, Under Special Instructions dated April 5, 1940 (DCSO rec, Vol 27 Pg 11509)

Proportional measurement - Set an iron post 3 ft. long, 1 in. diam., 28 ins. in the ground, for 1/4 sec. cor. of sec. 36 only, with brass cap marked:

¼ S36
1943 from which

A Fir, 9" dia., bears S.8½°W., 7 lks., marked ¼ S 36 BT.
A Fir 13" dia. bears N.38°W., 9 lks., marked ¼ S 36 BT.

Doug. Co. Surveyors Office - Vernon Tracy; Joe Brady; Jack Heritage - June 1966 - C.S. File 54/27-171

Found - 1943 GLO brass cap marked and in good condition.
9" Fir, now stump 2 ft. high, S.8½°W., 4.6 ft. (face), "¼S36 BT" on burned face.
13" Fir, turned out, N.38°W., 5.9 ft. face burned, fragmentary scribe visible.

New BTs - 5" D.Fir S.73°W., 38.9 ft. mkd. ¼ S36 CS BT.
7" Hemlock N.23°W., 22.4 ft. mkd. ¼ S36 CS BT.
Corner lies 25 ft. North of top of small spur sloping S.60°E.

Fd. and used - BLM Dependent Resurvey, 1972-75 (DCSO records, Volume 36 Page 15110)

Doug. County Surveyors Office - Randall Smith, Deputy; Stephen Flause - August 10, 1992 - C.S. File 64/32-2

Found - 2½" dia. GLO brass cap on a 1" O.D. Iron pipe, protrudes 1 ft. above ground.
9" now 9" dia., 2 ft. high rotted D.Fir stump, no blazes or scribing found, bears S.8½°W., 4.6 ft. (agrees w/record) (1943 GLO)
13" now 13" dia. down and rotted D.Fir, no blazes or scribing found, bears N.38°W., 5.9 ft. (agrees w/record) (1943 GLO)
7" now 13" dia. 2 ft. high Hemlock stump with a fully healed double blaze, bears N.23°W., 22.4 ft. (agrees w/record) (1966 DCSO)
SW BT from 1966 DCSO renewal is gone.
BLM 1972 BC/IP (W ¼ S31 T25S R2W only) bears South 73.9 ft. (agrees w/record)

Continued next page