

GOVERNMENT CORNER RESTORATION FORM

FILED

TOWNSHIP 26S RANGE 3W SEC. 1

PLSS # 600640

Date: 3/21/2023 By: JC
This survey consists of:

DOUGLAS COUNTY OREGON

DATE 3-7-23

Map: _____
Narrative: _____
Corner Rpt: CS 67/55-60

Corner Designation

DOUGLAS COUNTY
SURVEYOR

1/4 COR S 2 1/2 S 1

Monument(s) Found: (Condition and Source)

- Condition report
- Not Found
- Renewed
- Unrecorded
- Surveyed In

3 1/4" BLM BRASS CAP

UP 0.5

Previous Renewals

DCSO 1937 CS 30/21A AND

OLD CORNER BOOK PG 190

DCSO 1960 CS 52/58

BLM RESURVEY 1962-1963

VOL 32 PG 13377

FARR 1993 DP 1994-0042

CHRISTENSEN 1998 M 128-59

EDWARDS 1999 M 133-5

Accessories Found

DCSO 2008 CS 67/25-20

30" D. FIR S 75° W 40 FT (REC S 73° W) WITH
BURNED BASE NO VISIBLE FACE ADD 3 1/2" MAG
NAIL RIGHT SIDE CENTER

29" D. FIR S 41 1/2° E 19.5 FT (REC S 39° E 20.5 FT)
WITH BURNED BASE HEATED LOW BLAZE ADD
3 1/2" MAG NAIL RIGHT SIDE CENTER

BURD + SAWN 14" X 1 FT D. FIR STUMP N 61 1/2° W
47.5 FT (REC N 60° W HEATED LOW BLAZE ADD
3 1/2" MAG NAIL TOP CENTER

16" D. FIR N 53 1/2° E 39.3 FT (REC N 58° E)
BURNED BASE HEATED SINGLE BLAZE ADD 3 1/2"
MAG NAIL RIGHT SIDE CENTER

MONUMENT DETAIL

1/4
S 2 1/2 S 1
T 26S R 3W
1961

C.S. File 67/55-60

RENEWAL

Monument Set (Procedure and Description)

MONUMENT DETAIL

New Accessories

Sketch of Monument, Accessories, and General Area


Location & Comments

MONUMENT IN FIR & CEDAR WOODS
 N.W. QUADRANT CLEARED ON
 MODERATE SOUTH SLOPE

WOODEN CORNER
 POST FOR WIRE
 FENCES EAST 3 FT
 FENCES NORTH & EAST

Lat 43° 20' 14.34" N
 Long 123° 00' 39.16" W

AREA BURNED
 9-2020
 Comp. Decline. 14 1/2" E
 Agency DCSO
 Party Chief S. FINLISE
 Note keeper
 Witnesses J. LOYUNG

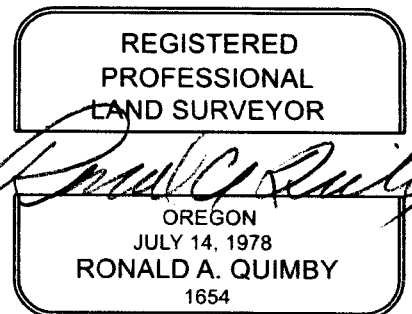

EXPIRES: 12/31/2024

CS 67/55-60
 213

PRIMARY CORNER DESCRIPTION 1/4 Cor. for Secs. 1 and 2

Alias _____ Description _____
Alias _____ Description _____
Alias _____ Description _____
Alias _____ Description _____

Original - Samuel C. Flint, Under Group #454, dated June 19, 1882 (DCSO Records, Vol. 11 Page 4398)

Set Cedar post, 3 ft. long, 3" sq., firmly in the ground for 1/4 sec. cor. marked 1/4 S on E and W faces, around which I put a pile of stones, no trees being near.

Arthur Boyer, Deputy Co. Surveyor - Wit: B.A. Lane Maurice Reid; Wldon Stone; Pickett McMillan - May 20, 1937 C.S. File 30/21A and "Old" Cor. Book, Page 190

Set from evidence on ground - E and W fence and pile of rocks confirmed on the ground by Pickett McMillan who saw original stake as set by US GLO for this 1/4 cor. and also by F.C. Frear who also saw this original stake as witnessed by McMillan.
Set 10 gauge shot gun barrel in ground and scribed:
 A Fir 15" dia., N.27 1/2°E., 28 ft.
 A Fir 18" dia., S.83°E., 14.7 ft.

Doug. County Surveyors Office - James Byron - For: Douglas County Road Dept. Wit: Milo Godfrey and C. Putnam Oct. 1960 - C.S. File 52/58

Found shotgun barrel at corner & both BTs, now stumps, show good scars, check bearing & distances.
New BTs - 7" R.Fir bears S.73°W., 3.6 ft. scribed 1/4 S2 CSBT
 18" R.Fir bears S.39 1/2°E., 20 ft. scribed 1/4 S1 CSBT

Bureau of Land Management resurvey by White, Beck and Reynolds Under Group #'s 242, 491, 527 - Survey, June 1962-Aug. 1963 (DCSO records, Vol. 32 Page 13377)

The 1/4 cor. perpetuated and recorded by A. Boyer, in 1937, monumented with a shotgun barrel in a mound of stone, and rehabilitated by J. Byron in 1960, from which the remains of the bearing trees marked by Boyer:
 A Fir stump 26" dia., bears N.26 1/2°E., 43 lks. dist. with a healed blaze.
 A Fir stump 24" dia., bears S.83 1/2°E., 23 1/2 lks. dist., with a healed blaze.
(Cont. Next Page)