

GOVERNMENT CORNER RESTORATION FORM

FILED

TOWNSHIP 25S RANGE 2W SEC. 20 PLSS # 240306

Date: 3/21/2023 By: X  
This survey consists of:

DOUGLAS COUNTY OREGON

DATE 3-15-23

Map: \_\_\_\_\_

Narrative: \_\_\_\_\_

Corner Rpt: 67/55-4

DOUGLAS COUNTY  
SURVEYOR

Corner Designation

1/4 COR 20  
29

Monument(s) Found: (Condition and Source)

3 1/4" BLM BRASS CAP  
UP 5"

\_\_\_ Condition report

\_\_\_ Not Found

Renewed

\_\_\_ Unrecorded

\_\_\_ Surveyed In

Previous Renewals

McChesney 1959 CS 53/112-26

BLM Resurvey 1962 Vol 32 pg 13237-8

Peel 1981 CS 58/256-1

DCSO 1986 CS 62/31-5

BLM Resurvey 1993 Vol 51 pg 19422

MONUMENT DETAIL

1/4 520  
529

T25S R2W  
1962

Accessories Found

SAWN BURNED 15" X 1 FT FIRE STUMP N18°E  
23.1 FT FACE INSIDE EVIDENT ADD 3 1/2"  
MAG NAIL TOP CENTER

C.S. File 67/55-6

RENEWAL

Monument Set (Procedure and Description)

MONUMENT DETAIL

New Accessories

5/8" X 30" I. Rod with DCSD plastic CAP  
N 53 1/2° E 11.7 FT up 4"

5/8" X 30" I. Rod with DCSD plastic CAP  
S 89 1/2° W 14.5 FT up 4"

5/8" X 30" I. Rod with DCSD plastic CAP  
N 21° W 10.2 FT up 4"

Sketch of Monument, Accessories, and General Area


Location & Comments

Gentle south slope running  
to steep south slope large  
clearcut to north tree  
line to south

AREA BURNED  
9-2020

Lat 43° 22' 23.49" N  
Long 122° 37' 41.59" W

Comp. Decline. 14 1/2° E  
Agency DCSD  
Party Chief S. F. HOUSE  
Note keeper  
Witnesses J. LORSUNG

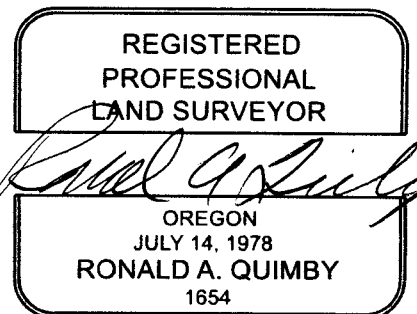

CS 67/55-61  
213

MM GPS 2/24/23  
TIME - 10:35  
H. I. - 2,000 M

3/15/23

TOWNSHIP 25 RANGE 02 POINT IDENTIFIER # 240300

PRIMARY CORNER DESCRIPTION 1/4 Cor. Secs. 20 & 29

Alias _____	Description _____
Alias _____	Description _____
Alias _____	Description _____
Alias _____	Description _____

Top of apparent orig, basalt corner stone protrudes 2" above ground lies along NW edge of I.P. stone, is firmly set. Did not disturb to look for marks.  
 Orig. BT, a 14" now 19" dia. 4 ft. high shattered rotted D.Fir stump with fragmentary scribing "20" bears N.25°E., 45.0 ft. (Agrees well with orig. brg. dist. 44.2 ft. is a face measurement:  
 Orig. BT a 6" now 19" dia. dead 50 ft. high D.Fir snag with a fully healed single blaze bears S.51½°E., 35.6 ft. (Rec. S.48°E. orig. & S.50°E., per 1962 resurvey, dist. agrees well with rec)  
 1962 BT, a 5" now 9" dia. dead D.Fir with a fully healed single blaze bears N.49½°W., 13.2 ft. (agrees with record).

- New BTs- 5" D.Fir double blazed & scribed "¼ S29 CS BT" bears S.25°W., 28.9 ft.
- 8" D.Fir double blazed & scribed "¼ S29 CS BT" bears S.86°W., 22.7 ft.
- 5" D.Fir double blazed & scribed "¼ S20 CS BT" bears N.18½°E., 23.7 ft.
- 8" chinquapin double blazed & scribed "¼ S20 CS BT" bears N.75°E., 28.9 ft.

**MONUMENT ON GENTLE SOUTH SLOPE RUNNING TO STEEP SOUTH SLOPE, LARGE CLEARCUT TO NORTH, TREE LINE SOUTH**

BLM Dependent resurvey by Wayne Rogers, Cadastral Surveyor & Robert Browning, Surveying Technician, under Group #1659, surveyed June/July 1993 - (DCSO records Vol. 51 Page 19422)

The ¼ sec. cor. of secs. 20 & 29, monumented with an iron post, 2½" dia., firmly set, projecting 6" above ground, with brass cap (properly) mkd. **3 ¼" BC PROT 5" MKD AS DESCRBD**

**GONE** A fir stump, 18" dia., bears N.27°E., 67 lks., with scribe marks S BT visible on decayed blaze.

**GONE** A fir snag, 18" dia bears S.50°E. 54 lks with healed blaze and the remains of a bearing tree mkd. by Brooks

**GONE** A fir stump, 11" dia., bears N.49½°W., 20 lks., with decayed snag lying alongside, with healed blaze.

and bearing trees mkd. by Smith & Flauser in 1986 **ADD 3 ½" MAGNAIL TOP CTR.**

**GONE** A fir, 7" dia., bears N.18°E., 25 lks., with healed blaze. **FACE INSIDE EVIDENT**

**GONE** A chinquapin, 8" dia., bears N.75°E., 43 lks., with scribe marks ¼ S20 CS BT visible on open blaze.

**GONE** A fir, 7" dia., bears S.25°W., 44 lks., with healed double blaze.

A fir, 11" dia., bears S.85°W., 33 lks., with healed double blaze.

SAWN, BURNED

BURNED TO GROUND  
INDISTINCT

DECLINATION 14 ½° E

**NEW REFS**  
5 1/8" X 30" IR/DC SO PLASTIC CAP, PROT 4", BEARS N 53 ½° E, 11 7/8 FT.

" " " S 89 ½° W, 14 5/8 FT.

" " " N 21° W, 10 3/8 FT.

CS 67/55-41  
3/13