

GOVERNMENT CORNER RESTORATION FORM

FILED

TOWNSHIP 25S RANGE 2W SEC. 6 PLSS # 148/100

Date: 3/22/2023 By: JC

This survey consists of:

Map: \_\_\_\_\_

DOUGLAS COUNTY OREGON

DATE 3-16-23

Narrative: \_\_\_\_\_

Corner Rpt: CS 67/55-63

Corner Designation

N 1/4 sec 6 only T26S-2

DOUGLAS COUNTY SURVEYOR

Monument(s) Found: (Condition and Source)

2 1/2" BRASS CAP UP 12"

\_\_\_ Condition report

\_\_\_ Not Found

Renewed

\_\_\_ Unrecorded

\_\_\_ Surveyed In

Previous Renewals

G10 Survey 1913 Vol 10 pg 4276

DCSO 1967 CS 54/40-54

BLM Resurvey 1972-1975 Vol 136 pg 15108

BAUGHMAN CS 58/100-1

MC Chesney 1976 CS 58/8-47

Schindell 2006 M 149-35

BLM Resurvey 2018-2020 Vol 59 pg 23915-16

MONUMENT DETAIL

County Surveyors OFFICE

1/4 T25S 56 T26S RW 1967

Accessories Found

Burned - Decayed 48" X 4 FT FIR STUMP S31°E 25.7 FT HEATED BLAZE ADD 3 1/2" MAG NAIL

Top Center

Burned - Decayed 56" X 5 FT FIR STUMP S54°W 24.5 FT (W-NAIL IN FACE NOTCH 21.8 FT)

Burned Dead 33" FIR N30°E 9.2 FT (REC 9.0 FT) ADD 3 1/2" MAG NAIL RIGHT SIDE CENTER

Burned-Dead 8" D. FIR S37°E 18.3 FT PARTLY HEATED LOWER BLAZE SCRIBES ILLEGIBLE ADD 3 1/2" MAG NAIL RIGHT SIDE CENTER

BURNED-DEAD 12" D. FIR S46°W 24.6 FT (REC 23.1 FT) ADD 3 1/2" MAG NAIL RIGHT SIDE CENTER

C.S. File 67/55-63

New Accessories

16" X 0.5 FT BURNED - SAWED D. FIR STUMP  
569°E 37.0 FT 3 1/2" MAG NAIL TOP CENTER

Sketch of Monument, Accessories, and General Area

Location & Comments


monument on moderate S.W.  
slope old growth to north  
Very large clearcut to south

AREA BURNED  
9-2020

OCRS COORDINATE SYSTEM  
Cottage Grove - Canyonville  
Zone.

Comp. Decline. 14 1/2° E  
Agency DCSO  
Party Chief S. F. HAUSE  
Note keeper  
Witnesses J. LORSUNG

N 186217.971  
E 257663.107

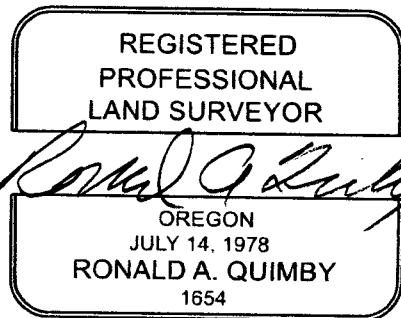

CS 67/55-63

TOWNSHIP 25 RANGE 02 POINT IDENTIFIER # 148100

PRIMARY CORNER DESCRIPTION No 1/4 Cor for Sec 6 only, T26-2

Alias \_\_\_\_\_ Description OGRS CANYONVILLE COTTAGE GRAVE COORDS  
 Alias \_\_\_\_\_ Description \_\_\_\_\_  
 Alias \_\_\_\_\_ Description 186217.971 N  
 Alias \_\_\_\_\_ Description \_\_\_\_\_  
257663.107 E

BLM dependent resurvey by Jeffrey O. Covington, Cadastral Surveyor, under Group No. 2919, surveyed May 2018/July 2020 - (DCSO records Vol. 59 Page(s) 23915-6)

The 1/4 sec. cor. of sec. 6 only, perpetuated by Schinnell, in 2006; monumented with an iron post, 1 1/4" dia., firmly set, projecting 14" above ground, with a brass cap (properly) mkd. from which the remains of the BTs mkd. by Collier in 1913

NOW BURNED  
48" X 4 FT TALL

A decayed fir stump, 48" dia., bears S.31°E., 25.7 ft. with a healed blaze

NOW BURNED

A decayed fir stump, 56" dia., bears S.54°W., 23.8 ft., no marks visible. - "W" NAIL IN FACE NOTCH 21.8 FT.

and the remains of a BT mkd. by the Douglas County Surveyor's Office in 1967, reported by Berry, Wofford, Popken, and Baughman in 1972-75

GONE - A decayed fir stump, 14" dia., bears S.54°E., 15.2 ft., no marks visible.

and a bearing tree mkd. by Schinnell 92  
A fir, 33" dia., bears N.30°E., 9.0 ft., with axe marks visible on bark.

BURNED DEAD

and new bearing trees  
AD fir, 8" dia., bears S.38°E., 18.3 ft., mkd. \* BT.

BURNED DEAD

AD fir, 12" dia., bears S.46°W., 23.1 ft., mkd. 1/4 SQ BT.

BURNED DEAD

NO NAILS FOUND

Each new BT has a 2 1/2" x 1/4" magnetic nail (Mag Nail) driven at the base right side-center & each monument established or remonumented has a magnet deposited in a white plastic case at the base of the stainless steel post. Alum. Angle iron driven alongside each monument.

DECLINATION 14 1/2° E

NEW REF

16" X 0.5 FT. BURNED SAWN, D. FIR STUMP 3 1/2" MAG NAIL TOP CNTR, S69°E, 37° FT.

MONUMENT ON MODERATE SW SLOPE, OLD GROWTH TO NORTH VERY LARGE CLEARCUT SOUTH.

CS 67/55-63

3/3