

GOVERNMENT CORNER RESTORATION FORM

FILED

TOWNSHIP 27S RANGE 7W SEC. 9

PLSS # 400500

Date: 4/4/2023 By: X

This survey consists of:

Map: _____

Narrative: _____

Corner Rpt: CS 67/55-66

DOUGLAS COUNTY OREGON

DATE 3-30-23

DOUGLAS COUNTY
SURVEYOR

Corner Designation

W.C. sec COR 9/10
16/15

Monument(s) Found: (Condition and Source)

DCSO BRASS CAP UP 1"
5/8" I. Rod with 12 engineering
Plastic Cap 0.35 FT South

Previous Renewals

DCSO 1960 CS 52/41

DCSO 1968 CS 54/23-28A

DCSO 1969 CS 54/23-35

Quimby 1984 M 96-55

BENTZ 1992 P.P. 1993-0018

BRITAIN 2010 M 157-34

___ Condition report

___ Not Found

Renewed

___ Unrecorded

___ Surveyed In

MONUMENT DETAIL

T 27S R 7W
WC
59/510
516/515
25 FT South
1969

Accessories Found

28" W. OAK N38°E 33.3 FT (REC N41 1/2°E)
Fully Heated Double BLAZE Re BLAZE ADD
3 1/2" MAG NAIL RIGHT SIDE CENTER

C.S. File 67/55-66

New Accessories

5/8" X 30" I. ROD WITH DCSD PLASTIC CAP
UP 3" BEAR S10°E 20.0 FT

5/8" X 30" I. ROD WITH DCSD PLASTIC CAP
UP 3" BEARS S67°W 23.4 FT


Sketch of Monument, Accessories, and General Area

Location & Comments

OCRS STATE PLAIN COORDINATE
SYSTEM Cottage Grove -
CANYONVILLE ZONE

N 144241.344
E 112805.489

Comp. Decline. 14 1/2° E
Agency DCSD
Party Chief S FRAUSE
Note keeper
Witnesses J. LORSON

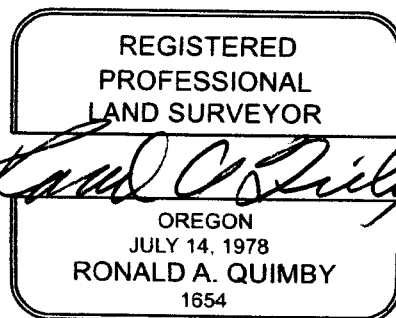

EXPIRES: 12/31/2024

CS 67/55-66
. 2/4

3/30/23

TOWNSHIP 27 RANGE 07 POINT IDENTIFIER # 400500

PRIMARY CORNER DESCRIPTION Sec Cor 9, 10, 15 and 16

Alias _____	Description <u>OCRS N-144241.344</u>
Alias _____	Description _____
Alias _____	Description <u>E-112805.489</u>
Alias _____	Description _____

Original - Dennis Hathorn, Deputy, under Contract #57 dated April 12, 1855 (DCSO records, Vol. 12 Page 5251)

Set post, cor. secs. 9, 10, 15 and 16, from which

- A B.Oak 12" dia., bears S.16°W., 71 lks. dist.
- A B.Oak 15" dia., bears S.71°E., 58 lks. dist.
- A W.Oak 12" dia., bears N.32°W., 171 lks. dist.
- A W.Oak 15" dia., bears N.20°E., 84 lks. dist.

Doug. County Surveyors Office - James Byron, Deputy - For: C.L. Brown - Wit. Milo Godfrey; Clete Putnam - August 19, 1960 - C.S. File 52/41

Found - Orig. 12" now 18" Oak snag N.32°W., 112.9 ft. I open & find good scribing "BT".

Orig. 15" now 24" W.Oak N.20°E., 55.4 ft. shows scar. I do not open.

No trace of SE or SW BTs found.

Set Brass cap at cor mkd County Surveyor's Office, 1960 S 9 | S 10 T27SR7W
S16 | S15

Corner is located thus. (See sketch in C.S. File)

New BTs - Rescribe W.Oak now 24" N.20°E., 55.4 ft. S10 T27S R7W CS BT.

21" R.Fir bears N.54°W., 82.6 ft. scribed S9 T27S R7W CS BT.

5" W.Oak bears S.24°W., 62.8 ft. scribed S16 CS BT.

Found OK, Vernon Tracy, Sept. 18, 1968 C.S. file 54/23-28A

Doug. County Surveyors Office - John Powell; Frank Jones; W. Penley - Dec. 9, 1969 - C.S. File 54/23-35

Found - ① Orig. 15" now 27" W.Oak N.20°E., 55.4 ft. shows good scar.

1960 DCSO brass cap. This cor. to fall in road due to new construction. Remove brass cap and reset for WITNESS CORNER.

② 21" now 23" D.Fir N.54°W., 82.6 ft shows good scar.

③ 15" now 18" D. Fir S.61°E., 125.5 ft. shows good scar.

Reset Brass cap for Wit. Cor. mkd: County Surveyor's Office, 1969 T27S/R7W
S9/S10 W.C. 25 ft. S16/S15

SEE BELOW

ADD 3 1/2" MAG NAIL RSC 38°

South to AS AT RIGHT 25 FT. SOUTH

28" Reblaze and rescribed 227" W.Oak N. 41° E., 33.3 ft. mkd. WC T27S R7W S10 CS BT. (REBLAZE)

GONE NO EVID. 23" D.FIR N. 71° W., 69.7 ft. mkd. W.C. T27S R7W S9 CS BT.

continued next page

PROT. 1"

FHDB

CS 67/55-66
3/4

TOWNSHIP 27 RANGE 07 POINT IDENTIFIER # 400500

PRIMARY CORNER DESCRIPTION Sec Cor for 9, 10, 15 and 16

Alias _____	Description _____
Alias _____	Description _____
Alias _____	Description _____
Alias _____	Description _____

GONE FDS ON STREAM EDGE
NOT FOUND - 5/8" R/W pin, S. 57° E., 18.2 ft. Station 217+00.
CAT BLADING IN VICIN.

~~① 18" D. Fir S. 53° E., 140.8 ft. mkd. W.C. T27S R7W S15 CS BT.~~
~~5/8" R/W pin, S. 57° E., 18.2 ft. Station 217+00.~~

Found OK, Ron Quimby, May 1984, M 96-55

Donald Bentz, For: Fred Engle - Oct. 1992 - Partition plat, 1993-0018

Set Witness Corner. → Set 5/8" Iron rod with cap marked "i.e. Engineering". True corner is 25 ft. South. Accessories per record.

FOUND PROT. 15" TOP BENT SOMEWHAT SOUTH 0 35' SOUTH FROM B.C. MON.

Fd. Ok by M. Brittain, Nov. ~~_____~~ M157-34

NEW REFS *2010*

<i>5/8" X 30" IR/PCSO PLST. CAP</i>	<i>SET PROT. 3" BEARS S 10° E, 20 0</i>
<i>"</i>	<i>" " 1" BEARS S 67° W, 23 4</i>