

GOVERNMENT CORNER RESTORATION FORM

TOWNSHIP 32S RANGE 7W SEC. 19

PLSS # 140340

FILED
Date: 4/4/2023 By: X

This survey consists of:

Map: _____

Narrative: _____

Corner Rpt: Cs 67/55-67

DOUGLAS COUNTY OREGON

DATE 3-31-23

DOUGLAS COUNTY
SURVEYOR

Corner Designation

C 1/4 sec 19

Monument(s) Found: (Condition and Source)

3 1/4" BLM BRASS CAP

UP 4"

Condition report

Not Found

Renewed

Unrecorded

Surveyed In

Previous Renewals

BLM Resurvey 2007 Vol 55 pg 2105-06

Quimby 2013 M 147-B

MONUMENT DETAIL

T 32S R 7W

C 1/4 S 19

2007

Accessories Found

14" FIR N 66° E 90.6 FT HEALD Single BLAZE

19" PONDEROSA PINE S 28 1/2° E 111.1 FT HEALD
Single BLAZE

C.S. File 67/55-67

New Accessories

1" Copper plug stamped DOUG CD set
 Flush in NEAR Vertical Rock outcrop
 S 2° E 25.5 FT


Sketch of Monument, Accessories, and General Area

Location & Comments

Lat: 42.77564 N
 Long: 123.57365 W

CORNER IS IN
 CUT Slope 20 FT +
 FROM E Low Creek
 ROAD

Comp. Decline. 14 1/2° E
 Agency DCSD
 Party Chief S. F. HAUSE
 Note keeper
 Witnesses J. LORSUNG

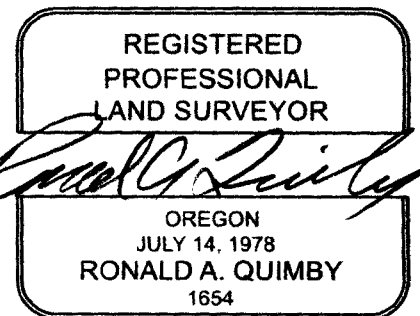

EXPIRES: 12/31/2024

CS 67/55-67
 2/3

RENEWED 3/31/23

TOWNSHIP 32 RANGE 07 POINT IDENTIFIER # 140340

PRIMARY CORNER DESCRIPTION Center 1/4 Cor. Sec. 19

Alias _____	Description <u>GPS POSITION NEEDS PROCESSING</u>
Alias _____	Description _____
Alias _____	Description _____
Alias _____	Description _____

BLM Dependent resurvey by Arthur R. Rambo, Cadastral Surveyor under Group No. 2179, surveyed July/Nov. 2007 - (DCSO records, Vol. 55 Page(s) 21605-6)

Point for the center 1/4 sec. cor. of sec. 19 at intersection with the E. and W. centerline.

Set a stainless steel post, 28" long, 2 1/2" dia., 25" in the ground, with brass cap mkd:

T32S R7W
C 1/4 S 19
2007

3 1/4" BC PROT. 4"

from which

14" - A fir, 10" dia., bears N.66° E., 90.6 ft., mkd. G 1/4 S 19 BT. **FHSB**

19" - A ponderosa pine, 14" dia., bears S.28 1/2° E., 111.1 ft. mkd. C 1/4 S 19 BT. **FHSB**

Deposit a magnet in a white plastic case at the base of the stainless steel post.

DECLINATION E

Fd. BC & accessories per rec. 12/11/2013 - R. Quimby M167-8

NEW REF

SET FLUSH IN NEAR VERTICAL ROCK OUT CROP

1" CORNER PLUG-MON "DOUG. CO.

BEARS S02° E, 25 1/2

CORNER IN CUT SLOPE 20 FT WEST FROM E COW CREEK RD.

42.77564
123.57365

CS 67/55-67

3/3