

GOVERNMENT CORNER RESTORATION FORM

FILED

TOWNSHIP 26S RANGE 7W SEC. 35 PLSS # 600100

Date: 4/17/2023 By: X

This survey consists of:

Map: _____

DOUGLAS COUNTY OREGON

DATE 3-30-25

Narrative: _____
Corner Rpt: CS 67 | 55-69

Corner Designation

Sec Cor

35/36
2/1 T27S R7W

DOUGLAS COUNTY
SURVEYOR

Monument(s) Found: (Condition and Source)

DCSO BRASS CAP

___ Condition report

___ Not Found

___ Renewed

___ Unrecorded

___ Surveyed In

Previous Renewals

DCSO 1938 CS 15/11

DCSO 1966 CS 54/23-27

DCSO 1971 CS 54/23-16

DCSO 1973 CS 56/34-7

BAUGHMAN 1974 M 52-12

Heimbürger 1990 M 109-27 A&B

Heimbürger 1999 M 133-72

K. DeGroot 2003 P.P 2003-0029

Accessories Found

MONUMENT DETAIL

COUNTY SURVEYORS
OFFICE

W. T. COR

T26S 53S | 53E

T27S 52 | 61

R7W 1966

45 FT W. TO

N.W. COR OF HOUSE S72°E 104.0 FT

WSW COR OF HOUSE S52°E 126.2 FT

Monument Set (Procedure and Description)

MONUMENT DETAIL

New Accessories

1" Copper Disk Doug Co. Surveyor over 3" MAG
Nail Flush in Road N 86 1/2° E 29.3 FT

1" Copper Disk Doug Co. Surveyor over 3" MAG
Nail Flush in Road N 86 1/2° E 56.6 FT

13" Power Pole $\begin{matrix} B \\ T \end{matrix}$ N 61° W 5.9 FT

29
M

32

2F

21

Sketch of Monument, Accessories, and General Area


Location & Comments

OCRS Coordinate System
Cottage Grove - Canyonville
Zone

N 154914.198

E 123465.346

Comp. Decline 14 1/2° E
Agency DCSO
Party Chief S. F. RAUSE
Note keeper
Witnesses J. LORSUNY

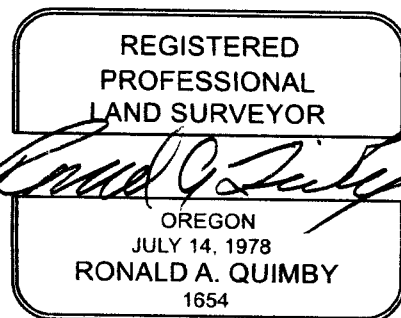

CS 67/55-69
2/3

