

GOVERNMENT CORNER RESTORATION FORM

TOWNSHIP 32S RANGE 8W SEC. 2 PLSS # 540600

FILED
Date: 4/17/2023 By: X
This survey consists of:

DOUGLAS COUNTY OREGON

DATE 4-4-23

Map: _____
Narrative: _____
Corner Rpt: CS67/55-70

Corner Designation

1/4 COR S2
S11

DOUGLAS COUNTY
SURVEYOR

Monument(s) Found: (Condition and Source)

BLM BRASS CAP
up 6"

- Condition report
- Not Found
- Renewed
- Unrecorded
- Surveyed In

Previous Renewals

BLM Resurvey 1973-1975
Vol 40 pgs 15987-8
BLM Resurvey 2014
Vol 58 pg 23377

MONUMENT DETAIL

T 32S 8W

1/4 S2
S11
1975

Accessories Found

21" FIRE STUMP 7' HIGH N49°E 33.7 FT
Healed BLAZE
47" FIR S27 1/4°E 92.4 FT BURNED BARK
No BLAZE VISIBLE
22" pine S31 1/4°W 34.6 FT Pitched over
SCAR Illegible Scribes
23" Pine N77 3/4°W 73.7 FT Pitched over
SCAR Illegible Scribes

RENEWAL

Monument Set (Procedure and Description)

MONUMENT DETAIL

New Accessories


Sketch of Monument, Accessories, and General Area

Location & Comments

Lat: 42.81088 N
 Long: 123.61285 W

ON Gentle SSE
 Slope 35'E South
 OF GRAVE ROAD
 Clear Cut, with A
 FEW STANDING TREES

Comp. Decline. 14 1/2° E
 Agency DCSO
 Party Chief S. F. AUSE
 Note keeper
 Witnesses J. LORSUNG

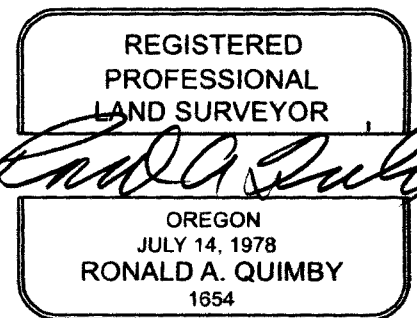

EXPIRES: 12/31/2024

CS 67/55-70
 213

MM GPS 4/4/23
TIME - 10:15
H. - 2.000M

FND OK

4/4/23

TOWNSHIP 32 RANGE 08 POINT IDENTIFIER # 540600

PRIMARY CORNER DESCRIPTION 1/4 Cor. Secs. 2 & 11

Alias _____	Description <u>GPS POSITION BEING PROCESSED</u>
Alias _____	Description _____
Alias _____	Description _____
Alias _____	Description _____

GLO survey by Richmond S. Dickerson, Deputy Surveyor under contract #474, dated May 10, 1883 - (DCSO records Vol. 21 Page(s) 8801)

Set a laurel post, 4 ft. long, 4" sq., 20" in the ground, for 1/4 sec. cor., marked 1/4 S on N side; from which
 A fir, 8" dia., bears N.60°E., 17 lks., mkd: 1/4 S BT.
 A laurel, 8" dia., bears S.20°E., 14 lks., mkd: 1/4 S BT.

Douglas Co. Surveyors Office - John Powell - 5/1968 - G.S. file 54/65-33

Reported as not found
Area cut & burnt

BLM dependent resurvey by Lynn M. Roseberry and Rollin D. Aanrud, Cadastral Surveyors, Group #821 & 876, surveyed July 1973/July 1975 - (DCSO records Vol. 40 Page(s) 15987-8)

Point for the 1/4 sec. cor. of secs. 2 & 11, at proportionate distance; there is no remaining evidence of the orig. corner. Set an iron post, 28 long, 2 1/2" dia., 22" in the ground with brass cap marked:

T32S R8W
 1/4 S 2
 S 11
 1975

from which
 A fir, 9" dia., bears N.49°E., 51 lks., mkd: 1/4 S2 BT.
 A fir, 38" dia., bears S.30°E., 140 lks., mkd: 1/4 S11 BT.

BLM resurvey by Brandon G Courtright, Cadastral Surveyor, under Group No. 2754, surveyed May/July 2014 - (DCSO records, Vol. 58 page(s) 23377)

The 1/4 sec. cor. of secs. 2 and 11, monumented with an iron post, 2 1/2" dia., firmly set, projecting 7" above ground, with brass cap (properly) mkd.

from which the remains of the bearing trees mkd. by Roseberry and Aanrud in 1973-75

21" DIAM. A fir stump, 7 1/2 ft. high, bears N.49°E., 33.7 ft., with a healed blaze.

47" A fir, 42" dia., bears S.27 1/2°E., 92.4 ft., with a healed blaze. (Record, S.30°E.) BURNED BARK, BLZ, NOT VIS, and new bearing trees

22" A pine, 17" dia., bears S.3 1/4°W., 34.6 ft., mkd. 1/4 S11 BT. PHSB

23" A pine, 18" dia., bears N.77 3/4°W., 73.7 ft., mkd. 1/4 S2 BT. PHSB

DECLINATION 14 1/2° E

SCAB'S ILLEG PITCHED OVER

ON GENTLE SSE SLOPE ~ 35 FT SOUTH FROM GRAVEL RD.
CLEAR CUT WITH A FEW STANDING TREES

CS 67/55-70
3/3

42.81088
123.61285