

GOVERNMENT CORNER RESTORATION FORM

FILED

TOWNSHIP 255 RANGE 3W SEC. 17

PLSS # 240 400

Date: 4/26/2023 By: [Signature]

This survey consists of:

Map: _____

Narrative: _____

Corner Rpt: CS 67/56-3

DOUGLAS COUNTY OREGON

DATE 4-12-23

DOUGLAS COUNTY
SURVEYOR

Corner Designation

$\frac{1}{4}$ COR $\frac{17}{20}$

Monument(s) Found: (Condition and Source)

2 1/2" BLM BEHSS CAP ON

1" ID Iron pipe

up 6"

Previous Renewals

BLM Resurvey 1940 Vol 27 pgs

11595-96

DCSO 1966 CS 54/27-22

Holt 1980 CS 58/163

EDWARDS 2002 M 140-45

- Condition report
- Not Found
- Renewed
- Unrecorded
- Surveyed In

MONUMENT DETAIL

$\frac{1}{4}$	<u>517</u>
	<u>520</u>
	1944

Accessories Found

Burned Dead 30" D Fir N87 1/2 W 70.0 FT

Good SCAR ADD 3 1/2" MAG NAIL RIGHT Side Center

Burned Stub 7" x 2 FT D. Fir N55°E 23.1 FT

Healed single blaze ADD 3 1/2" MAG NAIL RIGHT Side Center

C.S. File 67/56-3

RENEWAL

Monument Set (Procedure and Description)

MONUMENT DETAIL

BC Projecting 2 ft, Bent West -
referenced position, remove, straighten
& replace at referenced position, now
Projecting 6"

New Accessories

BURNED DEAD 28" D FIRE N15°W 30.8 FT
Not Blazed or Scribed 3 1/2" MAG NAIL
RIGHT Side Center


Sketch of Monument, Accessories, and General Area

Location & Comments

Lgt: 43° 23' 35.44 N
Long: 123° 04' 46.14 W

AREA BURNED
9-2020

Comp. Decline. 14 1/2° E
Agency DCSO
Party Chief S. F. AUSE
Note keeper
Witnesses FLORSUNG

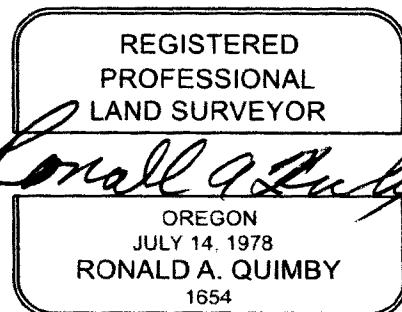

EXPIRES: 12/31/2024

CS 67/56-3
213

MM GPS 4/12/23
TIME - 9:30 - 10:30
11.1 - 2.000M

RENEWED 4/12/23

TOWNSHIP 25 RANGE 03 POINT IDENTIFIER # 240400

PRIMARY CORNER DESCRIPTION 1/4 Cor. for Secs. 17 and 20

Alias _____	Description <u>MM GPS POSITIONAL BEING PROCESSED</u>
Alias _____	Description _____
Alias _____	Description _____
Alias _____	Description _____

Original, Laban H. Wheeler, Under Contract #467 dated April 7, 1883 (DCSO Records, Volume 9 Page 3720)

Set Cedar post, 3 ft. long, 3" sq., 24" in the ground for 1/4 sec. cor. mkd. 1/4 S on N. face, from which

A Fir 30" dia., bears N.18°E., 22 lks. dist., mkd. 1/4 S BT.

A Fir 12" dia., bears S.27°W., 38 lks. dist., mkd. 1/4 S BT.

GLO Dependent Resurvey by Norman D. Price, Under Special Instructions dated April, 5, 1940. (DCSO records, Volume 27 Pages 11595-96)

Proportional measurement. Set an iron post, 3 ft. long, 1" dia., 28" in the ground, for 1/4 sec. cor., with brass cap mkd.

1/4 $\frac{S17}{S20}$
1944

from which

A Fir 14" dia., bears N.87 1/2°W., 106 lks. dist., mkd. 1/4 S17 BT.

A Fir 38" dia., bears S.72°W., 52 lks. dist., mkd. S20 BT.

This 1/4 corner is located on a spur, slopes NW.

Doug. County Surveyors Office - Vernon Tracy; Jack Heritage July 1966 - C.S. File 54/27-22

2 1/2 BRASS CAP ON 1" DIA. I.P. MKD AS ABOVE PROT. 2 FT BENT WEST - REFERENCE POSITION REMOVE STRAIGHTEN REPLACE AT REF. POSITION NOW PROT. 6" ADD 3 1/2" MAG NAIL R.S.C.

Found - 1943 GLO brass cap mkd.

BURNED DEAD 30-14" now 20" D Fir N.87 1/2°W., 70.0 ft. Alive and in good condition, shows very good scar. We do no open.

GONE NO EVID. 38" now 40" Fir, now turned out stump, S 72°W., 34.3 ft., shows healed blaze on bottom side.

GONE NO EVID. NEW BTs - 11" D Fir S.28°E., 36.5 ft. mkd. 1/4 S20 CS BT.

BURNED STUB 7" X 2 FT. 6" D Fir N.55°E., 23.1 ft. mkd. 1/4 S17 CS BT. FHSB.

This cor. lies on rolling top of spur, sloping NW. Find steel fence post set alongside brass cap.

Fd. BC and 3 BTs, Burton Holt, Aug. 1980, C.S. File 58/163

Found OK by D. Edwards, July 2002 - M140-45

NEW REF

BURNED DEAD 28" D FIR 3 1/2" MAG NAIL R.S.C., BEARS N05°W, 308 FT

CS 67/56-3

3/3

2 1/2 BRASS CAP ON 1" DIA. I.P. MKD AS ABOVE PROT. 2 FT BENT WEST - REFERENCE POSITION REMOVE STRAIGHTEN REPLACE AT REF. POSITION NOW PROT. 6" ADD 3 1/2" MAG NAIL R.S.C.

BURNED DEAD 30-14" now 20" D Fir N.87 1/2°W., 70.0 ft. Alive and in good condition, shows very good scar. We do no open.

GONE NO EVID. 38" now 40" Fir, now turned out stump, S 72°W., 34.3 ft., shows healed blaze on bottom side.

GONE NO EVID. NEW BTs - 11" D Fir S.28°E., 36.5 ft. mkd. 1/4 S20 CS BT.

BURNED STUB 7" X 2 FT. 6" D Fir N.55°E., 23.1 ft. mkd. 1/4 S17 CS BT. FHSB.

ADD 3 1/2" MAG NAIL R.S.C.