

GOVERNMENT CORNER RESTORATION FORM

TOWNSHIP 255 RANGE 3W SEC. 8 PLSS # 240540

FILED
Date: 4/24/2023 By: J
This survey consists of:

DOUGLAS COUNTY OREGON

DATE 4-13-23

Map: _____
Narrative: _____
Corner Rpt: C.S. 67/56-4

Corner Designation

C 1/4 58

DOUGLAS COUNTY
SURVEYOR

Monument(s) Found: (Condition and Source)

2 1/2" Alum. CAP ON 5/8"
IRON ROD UP 6"

- Condition report
- Not Found
- Renewed
- Unrecorded
- Surveyed In

Previous Renewals

EDWARDS 2001 M 136-33
CS 65/39-1B
Quimby 2007 CS 65/40-14

MONUMENT DETAIL

C 1/4 58
+
CS 2339

Accessories Found

Singed 16" D. FIR S29°W 6.1 FT Healed
SCAR ADD 3 1/2" MAG NAIL RIGHT SIDE CENTER

Singed 17" D FIR S75°W 12.1 FT (REC S71°W)
Healed SCAR Add 3 1/2" MAG NAIL RIGHT SIDE CENTER

16" X 0.5 FT SAWD Hemlock Stump N13°W 7.2 FT
(REC N18°W 7.5 FT) 3 1/2" MAG NAIL TOP CENTER

10" X 2 FT SAWD MADROVE STUMP N2°W
3.0 FT 3 1/2" MAG NAIL TOP CENTER

Steel Post 1 FT South

C.S. File 67/56-4

Monument Set (Procedure and Description)

MONUMENT DETAIL

New Accessories

SAWN 12" X 3'6" FT D. Fir Stump 5 1/2° E
 23.5 FT 3 1/2" MAG Nail Top Center

Sketch of Monument, Accessories, and General Area

Location & Comments

LAT 43° 24' 54.21" N
 LONG 123° 04' 44.63" W

MON. AT TOP OF
 Steep No Slope
 AT N. Edge FLAT
 Ridge Top

AREA BURDT

9/2020

Comp. Decline. 14 1/2° E

Agency DCSO


Party Chief S FIAUSE

Note keeper

Witnesses J LORSONG

CS 67/56-4

2/3

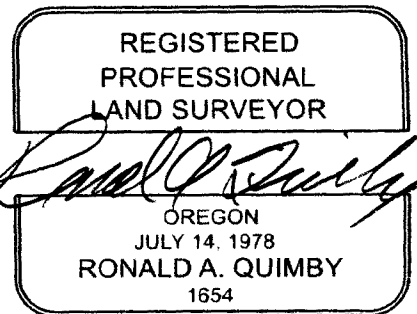

EXPIRES: 12/31/2024

MM GPS 11/29/21

43° 24' 54.21" N

4/13/23

TIME - 13:05

123° 04' 44.63" W

H.I. - 2.000M

TOWNSHIP 25 RANGE 03 POINT IDENTIFIER # 240540

PRIMARY CORNER DESCRIPTION Center 1/4 Sec. 8

Alias _____ Description _____
 Alias _____ Description _____
 Alias _____ Description _____
 Alias _____ Description _____

David Edwards - For: Roseburg Resources & Seneca Jones Timber Co. - Jan. 2001 - C.S. File 65/34-1B & M 136-33

Set - 5/8" x 48" steel pin w/alum. "ROSEBURG RESOURCES" set.

SINGED ALIVE 16"
 " " " 17"
 16" x 0.5 FT SAWN STUMP
 10" x 2 FT - SAWN STUMP

A 10" dia. D. Fir bears S. 29° W, 6.8 ft.
 A 10" dia. D. Fir bears S. 71° W, 12.5 ft.
 An 11" dia. Hemlock bears N. 18° W, 7.5 ft.
 A 10" dia. Madrone, bears N. 2° W, 3.0 ft.

C 1/4 58
 +
 LS 2339
 PROT. 6"

Ed. Ok by R. Quimby 3/2/2007 - C.S. File 65/60-14

FND. STEEL LATH 1 FT SOUTH

NEW REF

SAW D. FIR STUMP 12" x 3 1/2 FT 3 1/2" MAG NAIL TOP CNT. S 13 1/2° E, 23 5'

DECLINATION 14 1/2° E

MON. AT TOP OF STEEP NORTH SLOPE AND AT NORTH EDGE OF A FLAT RIDGE TOP

CS 67/56-4
3/3