

GOVERNMENT CORNER RESTORATION FORM

FILED

TOWNSHIP 25S RANGE 3W SEC. 8 PLSS # 300520

Date: 4/26/2023 By: X
This survey consists of:

DOUGLAS COUNTY OREGON

DATE 4-19-23

Map: _____

Narrative: _____

Corner Rpt C567/56-7

Corner Designation

S 1/16 S8/S9

DOUGLAS COUNTY
SURVEYOR

Monument(s) Found: (Condition and Source)

3/4" BLM BRASS CAP
up 4"

___ Condition report

___ Not Found

Renewed

___ Unrecorded

___ Surveyed In

Previous Renewals

BLM Established 1987
Vol 48 pg 18485
EDWARDS 2000-2001
M 136-33

MONUMENT DETAIL

S 1/16
S8/S9
1987

Accessories Found

Singed 16" D. Fir S29°E 9.0 FT (REC 14 LKS
9.24 FT) Fully Healed Single BLAZE
ADD 3 1/2" MAG NAIL RIGHT SIDE CENTER

17" Hemlock S85°E W 15.8 FT TO SHALLOW
Root Hole FALLEN OUT OF POSITION MOSTLY
BURNED AWAY

C.S. File 67/56-7

New Accessories

BURNED DEAD 10" Hemlock N 34° W 23.0 FT
3 1/2" MAG NAIL RIGHT SIDE CENTER NOT
BLAZED OR SCRIBED

BURNED DEAD 21" D. FIR 55° E 21.7 FT
3 1/2" MAG NAIL RIGHT SIDE CENTER NOT
BLAZED OR SCRIBED

Sketch of Monument, Accessories, and General Area

OCRS COORDINATE SYSTEM
Cottage Grove - Canyonville
Zone


N 210962.244
E 234191.218

Location & Comments

MOD. ON NEARLY
FLAT GROUND
APPROX. 170 FT
SOUTH OF GRAVEL
ROAD

AREA BURNED
9-2020

Comp. Decline. 14 1/2° E
Agency DCSO
Party Chief S. CLAUSE
Note keeper
Witnesses J. LORSON

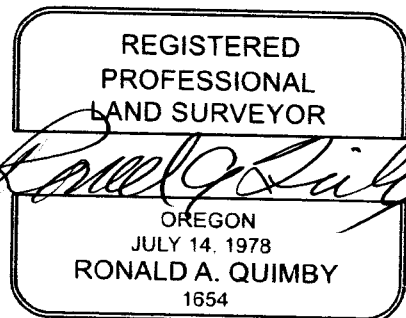

CS 67156-7 2/3

County Surveyor's Record, Douglas County, Oregon

18185

Dependent Resurvey of a Portion of the Subdivisional Lines,
T.25 S., R.3 W., Willamette Meridian, Oregon

CHAINS

A cedar, 13 ins. diam., bears N. 29° W., 50 lks. dist.,
with healed blaze.

and bearing trees mkd. by Vernon R. Tracy, Deputy County
Surveyor, in 1966

A cedar, 30 ins. diam., bears S. 58° E., 33 lks. dist.,
with scribe marks S16 CS BT visible on double blaze.

A hemlock, 11 ins. diam., bears N. 38° W., 24 lks. dist.,
with healed blaze.

N. 1° 26' 00" W., bet. secs. 8 and 9.

Descend over broken NE. slope, through heavy timber and dense
undergrowth.

6.80 Creek, 10 lks. wide, course NW.; asc. over SW. slope.

8.40 Spur, slopes W.; desc. over NW. slope.

19.995 Point for the S 1/16 sec. cor. of secs. 8 and 9.

Set a stainless steel post, 28 ins. long, 2 1/2 ins. diam., 24 ins.
in the ground, with brass cap mkd.

3 1/4" S 1/16
B C S 8 | S 9
1987

PROJ. 4'
90 F
924 FT.

300520
MON. ON NEARLY
FLAT GROUND APPROX.
170 FT. SOUTH FROM
GRAVELLED RD.

from which

A fir, 8 ins. diam., bears S. 20° E., 14 lks. dist.,
mkd. S 1/16 S9 BT. FHSB

A hemlock, 17 ins. diam., bears S. 85 1/2° W., 24 lks. dist.,
mkd. S 1/16 S8 BT.

Deposit a white "DEEP-1" magnetic marker at the base of the
stainless steel post.

Descend over NW. slope.

22.30 Dirt road, 20 lks. wide, bears NE. and SW.

39.990 The 1/4 sec. cor. of secs. 8 and 9, monumented with an iron post, 1
in. diam., firmly set, projecting 6 ins. above ground, with brass
cap mkd.

1/4
S 8 | S 9
1944

from which the remaining original bearing tree

A fir, 40 ins. diam., bears N. 55° E. 21 lks. dist.,
with healed blaze and rescribed by Arthur Boyer,
Deputy County Surveyor, in 1939, with scribe marks
1/4 S9 T25S R3W CS BT visible on bark blaze.

and a bearing tree mkd. by Arthur Boyer, Deputy County Surveyor,
in 1939

A maple, 24 ins. diam., bears S. 77° W., 55 lks. dist.,
with healed blaze. (Record, S. 74 1/2° W., 50 lks.)

and bearing trees mkd. by Vernon R. Tracy, Deputy County
Surveyor, in 1966

BURNED DEAD 10" HEMLOCK 3 1/2" MAG NAIL RSC N 34° W, 23 0 FT

BURNED DEAD 21" D. FIR " " " S 05° E, 21 7 FT

CS 47/56-7 3/3

DECLINATION 14 1/2° E

SINGED ALIVE 16" DIA.

FALLEN OUT OF POSITION -
ROTTED MOSTLY BURNED AWAY

NEW NEFS