

GOVERNMENT CORNER RESTORATION FORM

FILED

TOWNSHIP 25S RANGE 1W SEC. 18 PLSS # 104460

Date: 5-4-2023 By: X
This survey consists of:

DOUGLAS COUNTY OREGON

DATE 4-20-23

Map: _____

Narrative: _____

Corner Rpt: CS 67/56-9

Corner Designation

DOUGLAS COUNTY
SURVEYOR

N 1/16 120 518

Monument(s) Found: (Condition and Source)

3/4" BLM BRASS CAP

___ Condition report

___ Not Found

___ Renewed

___ Unrecorded

___ Surveyed In

Previous Renewals

SET BLM 1999 Vol 53

Pg 20708

RICE 2009 CM 159-39

MONUMENT DETAIL

T25S R1W

1/16

N 120

518

1999

Accessories Found

SAWN BURNED 22" X 1.5 FT FIR STUMP
N47°E 9.4 FT ADD 2" P.K NAIL Top Center

BURNED DEAD 14" D. FIR N85°W 39.0 FT
(REC 64 LBS 42.2 FT) ADD 3 1/2" MAG NAIL
RIGHT SIDE Center Fully Healed
SINGLE BLAZE

C.S. File 67/56-9

RENEWAL

Monument Set (Procedure and Description)

MONUMENT DETAIL

Blank lines for Monument Set description.

New Accessories

5/8" X 30" Iron Rod with yellow DCSD
PLASTIC CAP S24°E 19.5 FT UP 6"

Blank lines for New Accessories description.


Sketch of Monument, Accessories, and General Area

Location & Comments

LAT 43°24'15.98" N
LONG 122°52'12.66" W

AREA POINT
9/2020

Comp. Decline. 14 1/2° E
Agency DCSD
Party Chief S. F. AUSE
Note keeper
Witnesses J. LORSUNY

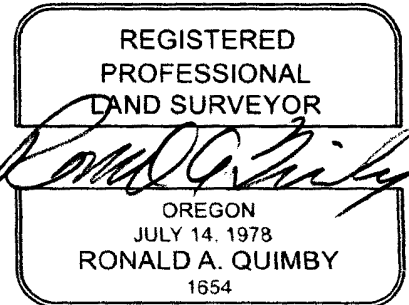

EXPIRES: 12/31/2024

CS 67/56-9

MM GPS 4/20/23

T25S, R01W, 104460

RENEWED 4/20/23

#2

20708

TIME-9:35

Hil. - 2.000M

Vol 53 Pg 20708

NAMED 25,01, 1/16 NW S18

Subdivision of Section 18,
T. 25 S., R. 1 W., Willamette Meridian, Oregon

CHAINS

Set a stainless steel post, 28 ins. long, 2 1/2 ins. diam., 25 ins. in the ground, with brass cap mkd.

3 1/4"

T 25 S R 1 W ✓

1/16

N 120

S 18

1999

M159-39

2009 Rice

~~12-6-1~~

~~M142-79~~

from which

SAWN, BURNED 22" X 1 1/2 FT STUMP

✓
990
ADD 2" PK NAIL TOP CNTR.
fir, 17 ins. diam., bears N. 47° E., 15 lks. dist., mkd. N 120 1/16 S18 BT.

BURNED DEAD 14" D

422 392
ADD 3 1/2" NAIL RSC
fir, 9 ins. diam., bears N. 85° W., 64 lks. dist., mkd. N 120 1/16 S18 BT. FHSB

Deposit a magnet in a white plastic case at the base of the stainless steel post.

S. 89° 37' 51" W., on the E. and W. centerline of the NW 1/4 of sec. 18.

Ascend broken SE. slope.

12.35 Ridge, bears N. 8° E. and S. 8° W.; desc. over SW. slope.

15.389 The N 1/16 sec. cor. of sec. 18 only, on the W. bdy. of the Tp.

GENERAL DESCRIPTION

The lands included in the foregoing survey are located in mountainous terrain, approximately 14 miles northeasterly from the community of Glide, Oregon.

The elevation ranges from about 1400 ft. above sea level along the East Fork of Rock Creek to about 3700 ft. above sea level in the SE 1/4 of sec. 21.

The area is drained by the East Fork of Rock Creek and its tributaries, and the tributaries of Canton Creek, all flowing southerly to the North Umpqua River.

Timber consists of fir, cedar, chinquapin, maple, madrone and scattered pine. Undergrowth consists of rhododendron, salal, vine maple, poison oak, Oregon grape, and fern.

DECLINATION 14 1/2° E

NEW REF

5/8" x 30" IR / NO. 50 YELLOW PLSTIC CAP

PROT 6" BEARS 524° E, 19.5 FT

CS67/56-9
313