

GOVERNMENT CORNER RESTORATION FORM

FILED

TOWNSHIP 255 RANGE 3W SEC. 25 PLSS # 600240

Date: 5/8/2023 By: X
This survey consists of:

DOUGLAS COUNTY OREGON

DATE 5-3-23

Map: _____
Narrative: _____
Corner Rpt: CS67/56-11

DOUGLAS COUNTY
SURVEYOR

Corner Designation

1/4 COR 26/25

Monument(s) Found: (Condition and Source)

___ Condition report

MON. Destroyed by Logging

___ Not Found

- Rusted Flange

Renewed

PIECES Found when Digging New

___ Unrecorded

Previous Renewals Hole

___ Surveyed In

BLM Resurvey 1940 Vol 24 pg 11542

BLM Resurvey 2008 Vol 57 pg 22419

MONUMENT DETAIL

Accessories Found

SAW N - Burnt - Rotted 32" X 2 FT FIR STUMP
N75°W 5.9 FT Healed BLAZE Add 3 1/2" MAG
NAIL Top Center

Burned - DEAD 9" D. FIR N 26 3/4° E 7.6 FT
ADD 3 1/2" MAG NAIL RIGHT Side Center
Fully Healed Single BLAZE

SAW N - Burnt 19" X 1 FT Cedar Stump
S 53 1/4° W 24.6 FT PARTIAL SCAR
Add 3 1/2" MAG Nail Top Center

C.S. File 67/56-11

1/4

RENEWAL

Monument Set (Procedure and Description)

3 1/4" DCSO Alum. Cap on
2" Alum. pipe up 8"
100 Rough Stone mound
2" x 30"

MONUMENT DETAIL

Douglas County
Surveyors Office
T25S R3W
1/4 526 / 525
2023

New Accessories

Sketch of Monument, Accessories, and General Area

CORNER IS ON GRADUAL EAST SLOPE
APPROX 180' FT EAST FROM 12' FT
WIDE GRAVEL ROAD BEARS N30W
AND S30E


OCRS COORDINATE SYSTEM
COTTAGE GROVE - CANYONVILLE
ZONE

N 192464.132
E 249265.710

Location & Comments

AREA BURD
9-2020

Comp. Decline. 14 1/2° E
Agency DCSO
Party Chief S. Krause
Note keeper
Witnesses J. LORSUNG

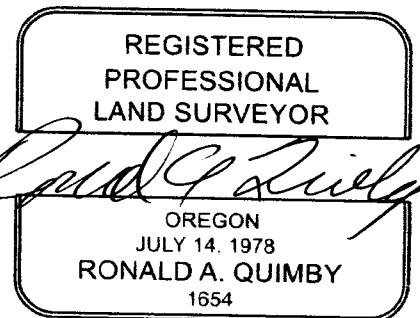

EXPIRES: 12/31/2024

2/4 CS 67/56-11

5/3/23

TOWNSHIP 25 RANGE 03 POINT IDENTIFIER # 600240

PRIMARY CORNER DESCRIPTION 1/4 Cor. for Secs. 25 and 26

Alias _____ Description RTK CCAS CANNONVILLE COTTAGE GROVE COORDS

Alias _____ Description _____

Alias _____ Description 192464.132 N

Alias _____ Description 249265.710 E

Original, Laban H. Wheeler, Under Contract #467 dated April 7, 1883 (DCSO Records, Volume 9 Page 3670)

Set cedar post, 3 ft. long, 3" sq., 24" in the ground for qr. sec. cor., mkd. 1/4 S on W. face, from which

- A Fir 10" dia., bears N.35°W., 9 lks. dist., mkd. 1/4 S BT.
- A Cedar 10" dia., bears N.31°E., 60 lks. dist., mkd. 1/4 S BT.

GLO Dependent Resurvey by Norman D. Price, Under Special Instructions dated April, 5, 1940. (DCSO records, Volume 27 Page 11542)

Point for original 1/4 sec. cor., determined by reference to the record measurements from both old bearing trees.

At point for corner, set an iron post, 3 ft. long, 1" dia., 28" in the ground, for 1/4 sec. cor., with brass cap mkd.

1/4
S 26 | S 25
1943

from which

- A Red Cedar 20" dia., bears N.37 3/4°E., 60 lks. dist., on which I uncovered the scribe marks 1/4 S BT beneath 60 years overgrowth.
- A Fir 30" dia., bears N.75°W., 9 lks. with blaze healed. (Old BT)
- A Fir 14" dia., bears N.42°E., 50 lks., mkd. 1/4 S-25 BT. (New BT)

BLM Dependent resurvey by A. Bert Skeesick & Kenneth W. Saveland, Cadastral Surveyors and Robert H. Browning, Survey Tech, under Group No. 2212 surveyed July/Oct. 2008 - (DCSO records Vol. 57 Page(s) 22419)

The 1/4 sec. cor. of secs. 25 and 26, monumented with an iron post, 1" dia., firmly set, projecting 7" above ground, with brass cap (properly) mkd. **1943 MON. GONE DUE TO LOGGING**

from which the remains of the original bearing trees

GONE - A partially uprooted cedar, 23" dia., bears N.37 1/4°E., 39.6 ft., with no scribe marks visible on an opened blaze. **ADD 3 1/2" MAG NAIL TOP CENTER** ✓ ✓

A sawed, decayed fir stump, 37" dia., bears N.75°W., 5.9 ft., with a healed blaze. ✓

and the remains of a bearing tree mkd. by Price **NEW CAP IS STAMPED**

AT DISTANCE INTERSECT FROM THE

continued next page **THREE FOUND BT'S**

WE SET A DCSO 3 1/4" ALUMINUM CAP

ON A 2 1/8" x 30" ALUMINUM PIPE.

MONUMENT IS SET PROTRUDING 8"

ABOVE GROUND IN A ROUGH MOUND OF STONE

T 25 S R 3 W
1/4 | S 25
S 26 | 1
2023

SAWN, BURNED 32" x 2 FT.
ROTTED
RUSTED PIPE
FLANGE PIECES
FOUND WHEN
SETTING NEW
MONUMENT

CS 67/56-11
314

TOWNSHIP 25 RANGE 03 POINT IDENTIFIER # 600240

PRIMARY CORNER DESCRIPTION 1/4 Cor. Secs. 25 & 26

| | |
|-------------|-------------------|
| Alias _____ | Description _____ |
| Alias _____ | Description _____ |
| Alias _____ | Description _____ |
| Alias _____ | Description _____ |

GONE - A roothole bears N.42°E., 33.0 ft., alongside of which is a down, decayed, fir snag, 21" dia., with a healed blaze.

and new bearing trees

✓ **AD** fir, 8" dia., bears N.26¼°E., 7.6 ft., mkd. ¼ S25 BT.

✓ **AD** cedar, 8" dia., bears S.53¼°W, 24.6 ft., mkd. ¼ S26 BT.

Corner is located on a gradual E. slope, E., 180 ft. from a gravel road, 12 ft. wide, bears N.30°W. ✓ and S.30°E. ✓

ADD 3 1/2" MAG NAIL R.S.C.
FHSB

BURNED DEAD 9" AD
SAWY BURNED 19" X 1 FT.
STUMPS

PARTIAL
BLAZE SCAR

DECLINATION 14 1/2° E

CS 67/56-11
414