

TOWNSHIP 25S RANGE 2W SEC. 20 PLSS # 240340

Date: 6/5/2023 By: E

This survey consists of:

Map: _____

Narrative: _____

Corner Rpt: CS 67/56-12

DOUGLAS COUNTY OREGON

DATE 5-4-23

DOUGLAS COUNTY SURVEYOR

Corner Designation

C 1/4 S20

Monument(s) Found: (Condition and Source)

5/8" Iron Rod set by
BAUGHMAN M 56-35

Condition report

Not Found

Renewed

Unrecorded

Surveyed In

Previous Renewals

DEGroot 2010 CS 65/59-20

MONUMENT DETAIL

5/8" I. ROD

Accessories Found

Burnt - SAWN 16" x 9" TALL D. FIR STUMP
S 16'12" E 21.6 FT (REC S 15'19" E 21.3 FT)
ADD 3 1/2" MAG NAIL TOP CENTER

5/8" Iron Rod S 63°00'42"W 22.28 FT
CAP GONE

5/8" Iron Rod N 14°49'22"W 21.08 FT
CAP GONE

Metal Post 1 FT South

A Cedar N 59 1/4° E 18.8 FT Burnt TO
GROUND

C.S. File 67/56-12

Monument Set (Procedure and Description)

MONUMENT DETAIL

New Accessories

BURNED - SAWN 13" X 7 FT D. FIRE STUMP
N 83° W 2.6 FT 3 1/2" MAG NAIL RIGHT
Side Center


Sketch of Monument, Accessories, and General Area

Location & Comments

Lat 43° 22' 49.41" N
Long 122° 57' 45.89" W

AREA BURNED
9-2020

Comp. Decline. 14 1/2° E
Agency DCSD
Party Chief S. F. HUSE
Note keeper
Witnesses J. LORSUNG

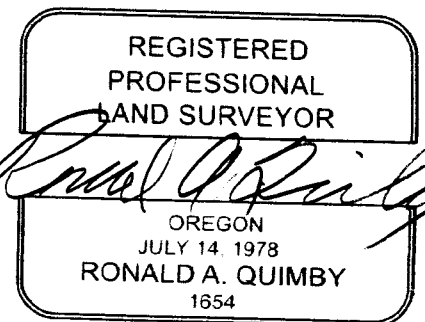

EXPIRES: 12/31/2024

CS 67/56-12

TOWNSHIP 25 RANGE 02 POINT IDENTIFIER # 240340 5/4/23

PRIMARY CORNER DESCRIPTION Center 1/4 Cor. Sec. 20

Alias _____	Description _____
Alias _____	Description _____
Alias _____	Description _____
Alias _____	Description _____

Glenn Baughman - For: Weyerhaeuser Co. - Jan. 1976 - M56-35

 Set - 5/8" iron rod.
 A 10" W.Fir, bears N.72°W., 5.6 ft. scribed C¼ S20 BT.
 A 24" Cedar, bears N.61°E., 18.5 ft. scribed C¼ S20 BT.

Kris DeGroot - May 6, 2010 - C.S. File 65/69-20

 Found - A 5/8" iron rod by G. Baughman in 1976 per M 56-35,
 firmly set, projecting 1" above the ground:
 From which a bearing tree by Baughman in 1976:
 A 28" Cedar bears N.59¼°E. 18 1/8 ft with scribe
 marks visible on a partially healed blaze.
 (Record N.61°E., 18.5 ft) 6
 A 11" D. fir bears S.15¼°E. 21 3/8 ft scribed "C¼ S20
 BT" BLAZE GONE 16 1/2" ADD 3 1/2" MAG NAIL TOP CNTR.
 A 5/8"x30" iron rod with plastic cap stamped "BTS CAP GONE
 ENG-SURV" bears S.63°00'42"W., 22.28 ft.
 A 5/8"x30" iron rod with plastic cap stamped "BTS CAP GONE
 ENG-SURV" bears N.14°49'22"W., 21.08 ft.

Note - All new bearing trees have double blazed faces with
 a brass washer stamped "PLS 1941" nailed into the
 lower blazed face. Bearings are measured to the
 center of the tree at the root crown and
 distances are measured to a nail in the root
 crown at the side and center of the tree. All
 bearing trees have a 6" red band painted around
 the tree and the blazed faces painted red and
 bearing tree signs nailed to the tree.

This corner renewal was performed by Lester L. Fanning, PLS 2664, and Scott McCurdy.

METAL LATH 1 FT. SOUTH

NEW REF.

BURNED SAWN 13" x 7 FT D. FIR STUMP, 3 1/2" MAG NAIL R. S. C.
 BEARS N83°W, 2 1/2 FT.

BURNED TO GROUND
 BURNED SAWN STUMP
 NEW 16" x 9" TALL

DECLINATION 14 1/2° E