

TOWNSHIP 25S RANGE 2W SEC. 11

PLSS # 600540

Date: 6/5/2023 By: [Signature]

This survey consists of:

Map: _____

Narrative: _____

Corner Rpt: CS 67/56-13

DOUGLAS COUNTY OREGON

DATE 5-4-23

DOUGLAS COUNTY
SURVEYOR

Corner Designation

1/4 COR S11/S12

SEE ALSO CS 67/58-21

Monument(s) Found: (Condition and Source)

___ Condition report

BLM BRASS CAP up 10"

___ Not Found

Rough Stone MOUND

___ Renewed

AROUND BASE

___ Unrecorded

Previous Renewals

___ Surveyed In

Hosford 1957 CS 42/308

McChesney 1970 CS 53/112-18

Ness 1995 M 123-3 A & B

BLM Resurvey 2001/2002

Vol 54 pgs 20938-9

MONUMENT DETAIL

T25S R2W

1/4

S11/S12

2001

Accessories Found

Burned - Rotted 38" X 3 FT FIR STUMP
56 S 1/4° E 29.8 FT

18" X 5 FT BURNED CEDAR STUMP S 71 1/2° W
81.6 FT (REC 81.0 FT)

BURNED DEAD 16" D. FIR S 7 1/2° W 25.2 FT
(REC 25.0 FT) Fully healed Double BLAZE
ADD 3 1/2" MAG NAIL RIGHT Side Center

BURNED - DEAD 23" D. FIR N 66 1/2° W 38.1 FT
Fully Healed Double BLAZE ADD 3 1/2" MAG
NAIL RIGHT Side Center

Steel Post 1 FT EAST OF B.C.

New Accessories

BURIED - DEAD 16" Red Cedar 540°W 24.3 FT
Not BLAZED or Scribed ADD 3 1/2" MAG
NAIL RIGHT SIDE CENTER

8' FT X 30' FT BASALT WALL N11E 10 FT ±

Sketch of Monument, Accessories, and General Area

Location & Comments

small stream flows southerly
is west 20 FT monument
just above bottom of
DRAW

MONUMENT IS
470' E EAST OF
GRAVEL ROAD

AREA BURNT
9-2020

OARS Coordinate System
Cottage Grove - Canyonville
Zone

Comp. Decline. 14 1/2° E

Agency DCSO


Party Chief S. Frause

Note keeper

Witnesses J. Loring

N 210270.846

E 280650.476

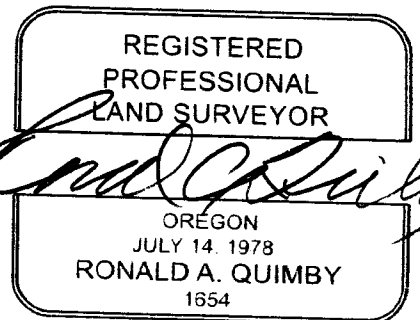

EXPIRES: 12/31/2024

5/4/23

TOWNSHIP 25 RANGE 02 POINT IDENTIFIER # 600540

PRIMARY CORNER DESCRIPTION 1/4 Cor Secs. 11 & 12

Alias _____ Description OORS CANYONVILLE
 Alias _____ Description COTTAGE GROVE COORDS
 Alias _____ Description _____
 Alias _____ Description 210270.846 N
280650.476 E

New BTs- 11" D.Fir S.7°16'W., 25.1 to center. 24.4 to "W" nail. Scribed "1/4 S11 BT."
 10" D.Fir N.66°05'W., 38.3 to center. 37.8 to "W" nail. Scribed "1/4 S11 BT."

BLM resurvey by A. Bert Skeesick, Cadastral Surveyor, Group #1979, surveyed 2001/2002- (DCSO rec. Vol. 54 Pages 20938-9)

The 1/4 sec. cor. of secs. 11 & 12 bears S.89°14'05"E., 2584.34 ft., perpetuated by Hosford, in 1957, further perpetuated by Ness, in 1995, monumented with an iron pipe, 2" dia., firmly set, projecting 10" above ground, with no cap, from which the remains of the bearing trees mkd. by Hosford

BURNED ROTTED
30" x 3 FT
18" x 5 FT BURNED

A fir stump, 48" dia., bears S.65 1/4°E. 24.8 ft., with scribe marks 25 3 BT visible on partially healed blaze.

{ADD 3 1/2" MAG NAIL R.S.C. TO FOUND BTs EXCEPT NE STUMP}

A cedar stump, 36" dia., bears S.71 1/2°W. 81.8 ft., with healed blaze. **BLAZE BURNED OUT**

BURNED DEAD 16" AD

and bearing trees mkd. by Ness fir, 14" dia., bears S.7 1/2°W., 25.8 ft., with healed double blaze.

FHDB

BURNED DEAD 23" AD

fir, 12" dia., bears N.66 1/2°W. 38.1 ft., with healed double blaze.

FHDB

At the corner point set a stainless steel post, 28" long, 2 1/2" dia., 18" in the ground, over existing iron pipe, in a mound of earth and stone, 2 ft. base to top, with brass cap mkd.

T25S R2W
 S 11 | S 12
 2001

MONUMENT IN STEEP ROCK RUBBLE SLOPE PROT 10" ABOVE GROUND ROUGH STONE MOUND OF STONE AROUND BASE

Deposit a magnet in a white plastic case at the base of the stainless steel post.

FOUND A STEEL LATH 1 FT. EAST FROM B.C. MON.

NEW REF

BURNED DEAD 16" R. CEDAR 3 1/2" MAG NAIL R.S.C. S40°W, 24.3

8' x 30' BASALT WALL, NNE ≈ 10 FT.

SMALL STREAM RUNNING SOUTHERLY IS WEST, 20 FT.

MONUMENT JUST ABOVE BOTTOM OF DRAW ≈ 470' EAST FROM GRAVEL RD.

DECLINATION 14 1/2° E

CS 67/56-13
 3/3