

TOWNSHIP 263 RANGE 2W SEC. 21 PLSS # 400300

Date: 6/5/2023 By: X
This survey consists of:

DOUGLAS COUNTY OREGON

DATE 5-11-23

Map: _____
Narrative: _____
Corner Rpt: C567/56-17

Corner Designation

CC 21 / 28 | 22

DOUGLAS COUNTY
SURVEYOR

Monument(s) Found: (Condition and Source)

1918 GLO BRASS CAP
UP 14" IN ROUGH MOUND
OF STONE

- Condition report
- Not Found
- Renewed
- Unrecorded
- Surveyed In

Previous Renewals

DCSD 1967 CS 54/40-59
EDWARDS 2004 M145-66
Hostetter 2005 M149-17

MONUMENT DETAIL

T26S T26S
CC 521 / 528 | R2W
522
R2W
1918

Accessories Found

BURNED REMNANT OF Hemlock AT
Root Hole N 79 1/4° W 18.1 FT

AREA Steep AND Burnt

New Accessories

5/8" x 30" I. Rod N46°E 7.2 FT
up 4"

5/8" x 30" I. Rod S50°E 7.2 FT
up 4"

Sketch of Monument, Accessories, and General Area

Location & Comments


OCS coordinate system
Cottage Grove - Canyonville
Zone

CORNER IS APPROX
300' SOUTH OF
Logging ROAD

N 165244.149
E 270686.079

Area Burnt
9/2020

Comp. Decline. 14 1/2° E
Agency DCSO
Party Chief S. F. AUSE
Note keeper
Witnesses J. Korsung

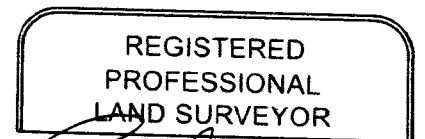

Ronald A. Quimby
OREGON
JULY 14, 1978
RONALD A. QUIMBY
1654

EXPIRES: 12/31/2024

CS 67/56-17 214

PRIMARY CORNER DESCRIPTION C C Secs. 21 & 28

Alias _____ Description _____
 Alias _____ Description _____
 Alias _____ Description _____
 Alias _____ Description _____

GLO survey by Wm. N. Gibb, Deputy Surveyor, under contract No. 783, dated Dec. 3, 1908 - (DCSO rec Vol. 10 Pages 4233-4)


Set a granite stone 6x8x14", 10" in the ground for cor. for cor. of secs. 21, 22, 27, & 28 marked with 3 notches on E & 2 notches on S edges, from which

- A laurel, 10" dia., bears N.49°E., 39 lks., mkd: T26S R2W S22 BT.
- A cedar, 30" dia., bears S.15°E., 43 lks., mkd: T26S R2W S27 BT.
- A maple, 7" dia., bears S.12°W., 75 lks., mkd: T26S R2W S28 BT.
- A laurel, 8" dia., bears N.18°W., 33 lks., mkd: T26S R2W S21 BT.

GLO resurvey by Fred Mensch, U.S. Cadastral Engineer; under Instructions dated May 25, 1916 & April 16, 1918, - (DCSO records Vol. 10 Page(s) 4330-1)

30.39 ch Intersect the closing cor. of secs. 21 & 28, established by me in 1916, which is an iron post, 3 ft. long, 2" dia, 12" above ground, marked & witnessed as described by the surveyor general. I now destroy this cor.

32.48 ch Intersect new W bdy of sec. 22
 At the point of intersection
 Set an iron post, 3 ft. long, 2" dia., 24" in the ground, for closing cor. of secs. 21 & 28, with brass cap mkd:

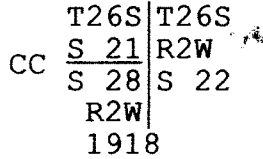

from which

- A hemlock, 6" dia., bears S.32°W., 33 lks., mkd: C C T26S R2W S28 BT.
- A fir, 40" dia., bears N.11°W., 50 lks., mkd: C C T26S R2W S21 BT.

Douglas Co. Surveyors Office - Vernon "Ray" Tracy - Jack Heritage - E. West - Aug 1967 - C.S. File 54/40-59

RENEWED 5/11/23

Found - GLO brass cap, properly marked in 1918 *PROT. 14" ABV. GRND. IN ROUGH MOUND OF STONE*

NO EVIDENCE ~~5 1/2" now 12" hemlock, snag, S.32°W., 21.8 ft. opened & fd scribing "8"~~

BURNED REMNANT AT ROOTHOLE ~~40" now 46" fir N.11°W., 33.0 ft. shows good face.~~

continued next page ~~New BTs- 10" hemlock N.79 1/2°W. 18 1/2 ft. mkd. T26S R2W S18 CC CS BT.~~

OVER →

MAY 11, 2023

TOWNSHIP 26 RANGE 02 POINT IDENTIFIER # 400300

PRIMARY CORNER DESCRIPTION C C Secs. 21 & 28

Alias _____	Description <u>CRS CANDANVILLE COTTAGE GROVE COURDS.</u>
Alias _____	Description _____
Alias _____	Description <u>165244.149 N</u>
Alias _____	Description <u>270686.079 E</u>

NO EVIDENCE
AREA STEEP AND BURNED

~~12" hemlock S. 45° W., 13.0 ft. mkd. T26S R2W S28 CC~~
 GS-BT. 300
 Note - This corner lies ~~350~~ 300 ft. south of logging road.

FD. Ok by D. Edwards 2/2004 - M143-66
 Fd. Ok by T. Hostetter, 12/2005 - M149-17

NEW REFS

5/8" x 30" IR NO CAP SET PROT. 4" ABV. GRND, BEARS N 46° E, 72 FT.
 " " " " , BEARS S 50° E, 72 FT.

CS 67/56-17
4/4