

GOVERNMENT CORNER RESTORATION FORM

TOWNSHIP 25S RANGE 2W SEC. 18 PLSS # 260460

FILED
Date: 6/19/2023 By: XC
This survey consists of:
Map: _____
Narrative: _____
Corner Rpt: CS 67/56-23

DOUGLAS COUNTY OREGON

DATE 5-23-23

DOUGLAS COUNTY
SURVEYOR

Corner Designation

N1/6 S18/517

Monument(s) Found: (Condition and Source)

- Condition report
- Not Found
- Renewed
- Unrecorded
- Surveyed In

1" Iron Pipe up 6"

Previous Renewals

Set BAUGHMAN 1976 M56-35
Quimby 2014 M 167-34A-B

MONUMENT DETAIL

Accessories Found

14" FIR 579°E 14.3 FT BURNED ROOTS

BURNED DEAD 8" FIR N68°E 3.5 FT (REC
N65°E 3.2 FT) FULLY HEATED DOUBLE BLAZE
FACE BURNT ADD 3 1/2" MAG NAIL RIGHT
SIDE CENTER

New Accessories

BURNED DEAD Double Trunk 23" Cedar
550°W 18.0 FT 3 1/2" MAG NAIL
RIGHT SIDE CENTER

Sketch of Monument, Accessories, and General Area

OCRS Coordinate System
Cottage Grove - Canyonville
Zone

N 206349.640


E 259909.029

Location & Comments

AREA BURNED

9-2020

Comp. Decline. 14 1/2° E
Agency DCSO
Party Chief S. FIAUSE
Note keeper
Witnesses J. LORSONG

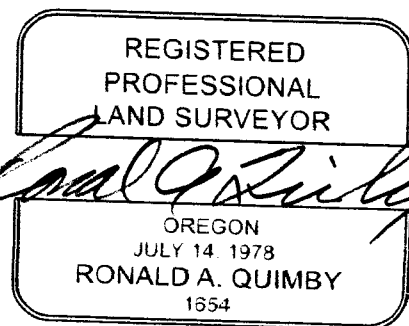

EXPIRES: 12/31/2024

CS 67/56-23

⑥ SET 5/8" IRON ROD WITH 2 1/2" ALUMINUM CAP MARKED:

ROSEBURG RESOURCES COMPANY
T25S R2W
NE1/16 • S18
2014
RLS 1654

NEW BEARING TREES:
9" FIR BEARS S62°E 11.7 FT
SCRIBED "NE 1/16 S18 BT"
16" FIR BEARS N33°W 17.5 FT.
SCRIBED "NE 1/16 S18 BT"

● N 1/16 S 18/17 **RENEWED 5/23/23**

FOUND 1" IRON PIPE PER M56-35
PROT. 6"
FOUND BEARING TREES:
14" FIR DOWN BEARS S75°E 14.3 FT
HEALED SCAR **BURNED ROOTS**
22" FIR STUMP BEARS S39°W 11.3 FT
HEALED SCAR **NO EVIDENCE**

NEW BEARING TREES:
8" FIR BEARS N88°E 3.2 FT
SCRIBED "N1/16 S17 BT" **PHOB FACE BURNED**
7" FIR BEARS S83°W 8.8 FT
SCRIBED "N1/16 S18 BT" **FALLEN ON FACE**

⑧ FOUND 1943 GLO BRASS CAP MARKED:

1943 US GENERAL LAND OFFICE SURVEY
PENALTY \$250 FOR REMOVAL
1/4 S18
1943

FOUND BEARING TREES:
10" FIR BEARS N41°W 19.4 FT
VISIBLE SCAR [NO RECORD]
27" (8" TALL) HEMLOCK STUMP
BEARS N77°E 13.7 FT VISIBLE SCAR
24" FIR BEARS S7°W 15.6 FT
VISIBLE SCAR [NO RECORD]
23" DOUGLAS FIR BEARS S57°W 15.2 FT
VISIBLE SCAR [NO RECORD]
62" FIR BEARS S18 1/2°E 42.9 FT
VISIBLE SCAR

⑨ SET 5/8" IRON ROD WITH 2 1/2" ALUMINUM CAP MARKED:

ROSEBURG RESOURCES COMPANY
T25S R2W
CW1/16 • S18
2014
RLS 1654

NEW BEARING TREES:
24" WHITE FIR BEARS N8°E 23.5 FT.
SCRIBED "CW 1/16 S18 BT"
10" WHITE FIR BEARS S87°E 13.8 FT.
SCRIBED "CW 1/16 S18 BT"

⑩ SET 5/8" IRON ROD WITH 2 1/2" ALUMINUM CAP MARKED:

ROSEBURG RESOURCES COMPANY
T25S R2W
C1/4 • S18
2014
RLS 1654

NEW BEARING TREES:
14" DOUGLAS FIR BEARS N87°E 24.4 FT
SCRIBED "C 1/4 S18 BT"
12" WHITE FIR BEARS S46°E 10.8 FT
SCRIBED "C 1/4 S18 BT"
10" WHITE FIR BEARS S38°W 11.4 FT
SCRIBED "C 1/4 S18 BT"
15" DOUGLAS FIR BEARS N19°W 3.9 FT
SCRIBED "C 1/4 S18 BT"

⑪ SET 5/8" IRON ROD WITH 2 1/2" ALUMINUM CAP MARKED:

ROSEBURG RESOURCES COMPANY
T25S R2W
CE1/16 • S18
2014
RLS 1654

NEW BEARING TREES:
16" DOUGLAS FIR BEARS S75°E 10.5 FT
SCRIBED "CE 1/16 S18 BT"
16" FIR BEARS S75°E 10.5 FT
SCRIBED "CE 1/16 S18 BT"
15" DOUGLAS FIR BEARS N35°W 16.3 FT
SCRIBED "CE 1/16 S18 BT"

⑫ FOUND D.C.S.O. BRASS CAP ON IRON PIPE WITH STONE ALONGSIDE MARKED:

DOUGLAS COUNTY SURVEYOR'S OFFICE
T25S R2W
1/4
S18 | S17
1989

FOUND BEARING TREES:
16" DOUBLE TRUNKED CEDAR. EAST TRUNK
BEARS NORTH 24.2 FT VISIBLE SCAR
11" DOUGLAS FIR BEARS N72°W 23.6 FT
VISIBLE SCAR
12" DOUGLAS FIR BEARS S44°W 41.0 FT
VISIBLE SCAR.
62" DOUGLAS FIR BEARS S75°E 4.5 FT
HEALED SCAR
32" CEDAR STUMP (2 FT TALL)
BEARS N71°W 35.0 FT

⑬ FOUND 3 1/4" BRASS CAP ON IRON PIPE FLUSH WITH THE GROUND MARKED:

US DEPT OF INTERIOR
1/4 S18
S19
T25S R2W
1962
BUREAU OF LAND MANAGEMENT

FOUND BEARING TREES:
35" (4 FT TALL) CEDAR STUMP
BEARS N81 1/2°E 30.6 FT
9" MADRONE N2 1/2°E 17.5 FT
VISIBLE SCAR
17" HEMLOCK BEARS N89 1/2°W 25.7 FT
VISIBLE SCAR
14" HEMLOCK BEARS S13°W 1.8 FT
VISIBLE SCAR

Date: 2/21/2014 JC
This survey consists of:
Map: M167-34 A+B
Narrative: _____
Corner Rpt: _____

DOUGLAS COUNTY
SURVEYOR

DECLINATION 14 1/2° E

NEW REF.

**BURNED DEAD DOUBLE TRUNK 23" CEDAR
PLACE 3 1/2" MAG NAIL R. S. C.
TREE BEARS S 50°W, 18° FT**

**OCRS CANYONVILLE COTTAGE GROVE COORD.
206349.640 N
259909.290 E**

ED:

AS COUNTY
0

ED:

AS COUNTY
140500

AS COUNTY
RENEWAL

NY

ALUMINUM CAP

NY

**CS 67/56-23
3/3**

**2014
M 167-34**

**REGISTERED
PROFESSIONAL
LAND SURVEYOR**

**OREGON
JULY 14, 1879
RONALD A. GURNEY
1964**