

TOWNSHIP 25S RANGE 3W SEC. 13 PLSS # 700 400

Date: 6/26/2023 By: X
This survey consists of:

DOUGLAS COUNTY OREGON

DATE 6-21-23

Map: _____
Narrative: _____
Corner Rpt: CS 67/56 38

DOUGLAS COUNTY SURVEYOR

Corner Designation

see Cor $\frac{13}{24} \Big| 18$

Monument(s) Found: (Condition and Source)

2 1/2" 1943 GLO BRASS CAP
ON 2" O.D IRON PIPE
UP 9"

Previous Renewals

GLO Resurvey 1940 Vol. 27
pg 11514-15
JULIANO 1976 CS 58/130
DCSD 1981 CS 61/29-10
DCSD 1995 CS 64/58-8

- Condition report
- Not Found
- Renewed
- Unrecorded
- Surveyed In

MONUMENT DETAIL

T25S T25S
513 | R2W
524 | S18
R3W
1943

Accessories Found

28" X 6 FT Tipped out AND BURNT D. FIR
STUMP S57 1/2° E 17.8 FT OPEN BLAZE NO
SCRIBE VISIBLE

36" X 5 FT D. FIR STUMP S21 1/2° W 17.6 FT
REC S17 1/2° W 17.5 FT HEATED SINGLE BLAZE
ADD 3 1/2" MAG NAIL RIGHT SIDE CENTER
75" D. FIR BURNT - DEAD N36 1/2° W 24.4 FT
(REC 24.5 FT) ADD 3 1/2" MAG NAIL RIGHT
SIDE CENTER SCAR NOT VISIBLE

14" D. FIR BURNT & DEAD S68° W 22.3 FT
(REC 22.1 FT) ADD 3 1/2" MAG NAIL RIGHT
SIDE CENTER SCAR NOT VISIBLE

New Accessories

Sketch of Monument, Accessories, and General Area

Location & Comments

CORNER ON SHALLOW SE'LY
Slope 265 FT North of
AND HALFWAY between two
Northerly Running Logging
SPUR RDS


AREA BURNED
9. 2020

OCRS COORD. Reference
System Cottage Grove
CANYONVILLE ZONE

N 202752.681

E 255486.352

Comp. Decline 14 1/2° E
Agency DCSO
Party Chief S. KRAUSE
Note keeper
Witnesses J LORSUNG

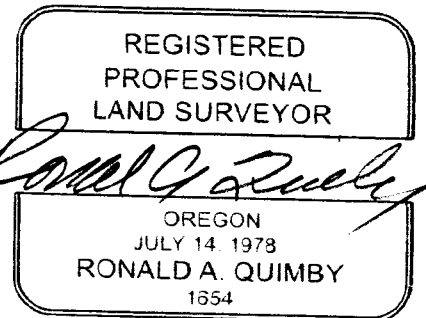

EXPIRES: 12/31/2024

CS 67/56-38
2/3

TOWNSHIP 25 RANGE 02 POINT IDENTIFIER # 100407

PRIMARY CORNER DESCRIPTION Sec. Cor. for 13 & 24 only, T25-3

Alias _____ Description QERS CANYONVILLE COTTAGE GROVE COORDS

Alias _____ Description _____

Alias _____ Description 202752.681 N

Alias _____ Description 255486.352 E

Found - 1943 GLO brass cap, properly mkd. firmly set.
 Orig. 24" now 38" Fir, alive with large pitched over scar, bears S.55°E., 17.8 ft.
 Orig. 30" now 47" Fir stump (7 ft. high) with well healed scar, bears S.21°W., 17.2 ft. (Rec. 15.8 ft., fits to face fairly good)
 Orig. 18" now 16" rotted Fir snag (10 ft. tall) bears N.38°W., 84.6 ft. (Rec. 85.1 ft.) scribed "T25S R3W S13 BT" visible on East side of tree.
 9 now 12" Hemlock per 1943 resurvey, down with well healed scar bears N.38½°W., 12.5 ft. to root hole.

New BTs- 13" Hemlock bears S.1°E., 36.8 ft. scribed "T25S R2W S18 CS BT" in double blaze.
 10" Hemlock bears N.87°W., 18.0 ft. scribed "T25S R3W S13 CS BT" in double blaze.
 9" Hemlock bears N.45°W., 62.0 ft. scribed "T25S R3W S13 CS BT" in double blaze.

Corner lies in cut line west of rock road approx. 50 ft.

Douglas Co. Surveyors Office - Randall Smith & Stephen Flause
 March 30, 1995 - C.S. 64/58-8

RENEWED 6/21/23

MARKED PER 1940 RENEWAL PROT. 9"

Found - 2½" dia. Glo Brass cap on a 2" O.D. I.P. protrudes 7" above ground.

TIPPED BURNED 28" X 6 FT.

BURNED 36" X 5 FT STUMP

24" now 34" dia. 6' high tipped out D. Fir stump with a fully healed single blaze, estimated root wade, bears S.57½°E., 17.8 (agrees w/ rec.) OBT
 30" now 46" dia. 5' high D. Fir stump with a fully healed single blaze, bears S.17½°W., 17.5' (rec. S.17½°W., 15.8' dist could be a face measurement) OBT (stump is solid in good shape).

BLAZE NOW OPENED, NO SCRIBG SEEN
 W 2 W 17 6
 ADD 3 1/2"
 MAG NAIL R.S.C.

No other OBT's or 1943 renewal BT are found.

13" now 14" dia. 6' high Hemlock stub with scribing visible on an unhealed open blaze "T25S R2W S18 CS" bears S.1°E., 36.8' (agrees w/rec.) 1981 DCSO

10" now 12" dia. 2' high Hemlock stub with scribing visible on an unhealed open blaze "S BT", bears N.87°W., 18' (agrees with rec) 1981 DCSO.

NO EVIDENCE REMAINS

1981 DCSO Hemlock BT bears N.45°W., 62' is now gone.

New BTs- 5" dia. Hemlock, double blazed and scribed "X BT" bears S.0½°W., 66.7'.

BURNED DEAD 15"

4" dia. D. Fir, double blazed and scribed "X BT", bears N.36½°W., 24.5'. 24 4

ADD 3 1/2" MAG NAIL R.S.C.

BURNED DEAD 14"

3" dia. D. Fir, double blazed and scribed "X BT", bears S.68°W., 22.1'. 22 3

ADD 3 1/2" MAG NAIL R.S.C.

DECLINATION 14 1/2° E

MONUMENT ON SHALLOW SE'LY SLOPE [REDACTED] FT. NORTH OF AND ≈ HALF WAY BETWEEN TWO NTH'LY RUNNING LOGGING SPUR RD.S