

TOWNSHIP 255 RANGE 2W SEC. 18 PLSS # 100400

Date: 6/26/2023 By: X  
This survey consists of:

DOUGLAS COUNTY OREGON

DATE 6-21-23

Map: \_\_\_\_\_  
Narrative: \_\_\_\_\_  
Corner Rpt: CS67/56-39

DOUGLAS COUNTY  
SURVEYOR

Corner Designation

CC | S18  
      | S19

Monument(s) Found: (Condition and Source)

2 1/2' GLD BRASS CAP 1943  
up 13" Leans slightly SSE

\_\_\_ Condition report  
\_\_\_ Not Found  
 Renewed  
\_\_\_ Unrecorded  
\_\_\_ Surveyed In

Previous Renewals

GLD Resurvey 1940 Vol 27 pg 11514  
DCSO 1962 CS 49/102-7  
DCSO 1965 CG 54/27-166  
DCSO 1985 CS 64/58-11  
BLM Resurvey 2014-2015  
Vol 58 pg 23333

MONUMENT DETAIL

T255  
T255 | S18 CC  
R3W | S19  
S24 |  
      R2W  
      1943

Accessories Found

Burned. Very Rotted 48" X 1 1/2 FT D. FIRE  
STUMP S70°E 35.6 FT

17" X 1 1/2 FT Hemlock stump S68°E 14.1 FT  
(Rec S69 3/4°E 14.0 FT) Healed Lower BLAZE  
ADD 3 1/2" MAG NAIL Top Center

Burned, Sawn  
12" X .75 FT D. FIRE STUMP S12 1/2°E 18.3 FT  
(Rec S14°E) Portion of Lower BLAZE ADD  
3 1/2" MAG NAIL Top Center

C.S. File 67/56-39

New Accessories

5/8" X 30" Iron Rod with DCSD yellow  
Plastic Cap N 64°E 13.0 FT up 8"

5/8" X 30" Iron Rod with DCSD yellow  
Plastic Cap S 49 1/2°E 12.0 FT up 8"

5/8" X 30" Iron Rod with DCSD yellow  
Plastic Cap N 9°W 8.0 FT up 10"

Sketch of Monument, Accessories, and General Area

Location & Comments


CORNER ON SHALLOW ESE  
SLOPE IN LARGE BURNED  
CLEAR CUT APPROX 200' S 45°E  
FROM LOGGING SPUR ROAD

AREA BURNED  
9-2020

OCRS COORD. Reference  
System Cottage Grove  
CANYONVILLE ZONE

Comp. Decline. 14 1/2°E  
Agency DCSD  
Party Chief SFAUSE  
Note keeper  
Witnesses J. LORSUNG

N 202277.740  
E 258484.987

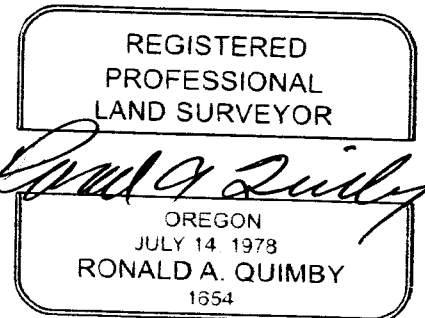

EXPIRES: 12/31/2024

CS 67/56-39

TOWNSHIP 25 RANGE 02 POINT IDENTIFIER # 100400

PRIMARY CORNER DESCRIPTION C C for Secs. 18 & 19 only (West)

Alias _____	Description _____
Alias _____	Description _____
Alias _____	Description _____
Alias _____	Description _____

Doug. Co. Surveyor Office - Vernon Tracy; Mike Stone; Jack Heritage - February 1966 - C.S. File 54/27-166

-----

Found - 1943 GLO brass cap.  
 All BTs are now turned out or stumps including BTs recorded by Godfrey.

New BTs- 15" R.Cedar N.42°E., 49.1 ft. mkd: CC T25S R2W S18 CS BT.  
 9" Laurel S.21°E., 22.3 ft. mkd: CC T25S R2W S19 CS BT.  
 4" I.Pipe is driven into stump of 14" Hemlock S.28°E., 55.2 ft. Pipe is weld marked "T25S R2W S19 CC BT" and stands 4.4 ft. above stump.

Corner lies in NW corner of cut off unit.

Douglas County Surveyors Office - Randall Smith & Stephen Flause - Mar. 30, 1995 - C.S. 64/58-11

-----

Found - 2½" dia GLO brass cap on a 2" O.D. iron pipe protruding 12" above ground. (1943 GLO)  
 5" now 12" dia., 25' high cedar snag with a partially healed rotted single blaze, scribing visible "T25S R2W S18" and a fully healed double blaze on south trunk, bears N.66½°E., 18.4' (agrees with 1943 rec.,.)  
 60" now 64" dia. 2' high rotted D.Fir stump with evidence of a lower blaze, no scribing found, bears S.70°E., 35.6' (agrees with rec.)

New - 7" dia., hemlock double blazed and scribed "CCT25S R2WS18 CSBT" bears N.15½°E., 12.2 ft.  
 11" dia., Hemlock double blazed and scribed "CCT25S R2WS19 CSBT" bears S.58°E., 14.0 ft.  
 4" dia., hemlock double blazed and scribed "X BT" bears N.61°E., 4.0 ft.  
 8" dia., fir double blazed & scribed "CCT25S R2WS19 CSBT" bears S.12½°E., 18.1 ft.  
 Dec. 17¾°E

*RENEWED 6/21/23*

BLM Dependent resurvey by Richard J. Dieckmann, Cadastral Surveyor, under Group No. 2749, surveyed Aug. 2014/April 2015 - (DCSO records Vol. 58 Page(s) 23333)

-----

The closing cor. of secs. 18 and 19, on the W. bdy. of the Tp., perpetuated by Godfrey, in 1962, further perpetuated by the Douglas Co. Surveyor's Office in 1966 & 1995, monumented with an iron post, 2" dia., firmly set, projecting 5" above the ground, with a brass cap (properly) mkd. ✓ 2" dia BC  
 continued next page PROT. 13" LEANS SLIGHTLY SSE

CS 67/56-39  
3/4

PRIMARY CORNER DESCRIPTION CC for Secs 18 & 19 only (West)

Alias \_\_\_\_\_ Description DCRS CANYONVILLE COTTAGE GROVE COORDS  
 Alias \_\_\_\_\_ Description \_\_\_\_\_  
 Alias \_\_\_\_\_ Description 202277.740 N  
 Alias \_\_\_\_\_ Description 255484.987 E

**MON. DESCRIPTION ON PG. 2**

**NO EVIDENCE** - A red cedar snag, 11" dia., bears N.66½°E., 18.5 ft., with scribe marks T25S R2W S18 BT visible on a partially healed blaze. This snag is leaning to the SE.  
**BURNED VERY ROTTED**  
**48" X 1 1/2' STUMP** A D. Fir stump, ~~54"~~ dia., bears S.70°E, 35.6 ft., with no marks visible.  
 and BTs mkd. by the Douglas County Surveyor's Office in 1995  
**NO EVID.** A hemlock, 10" dia., bears N.15°E., 12.0 ft., with a healed double blaze.  
**NO EVID.** A hemlock, 6" dia., bears N.59¼°E., 4.0 ft., with a healed double blaze.  
**BURNED SAWN** 17" x 1 1/2" hemlock ~~15"~~ dia., bears S. <sup>68°</sup>59¼°E., 14 <sup>1</sup>/<sub>8</sub> ft., with a healed double blaze - **HEALED 12 1/2° LOWER BLZ.**  
**BURNED SAWN** 12" x 7.5" D. Fir, 10" dia., bears S. ~~14°~~ E, 18.3 ft., with a healed double blaze. **PORTION OF LOWER BLZ.**

ADD 3 1/2" MAG NAIL TOP CNTR.  
 ADD 3 1/2" MAG NAIL TOP CNTR.

**NOT FOUND**

The reference monument established by the Douglas County Surveyor's Office in 1966, an iron pipe, 4" dia., 8 ft. long, with weld marks T25S R2W S19 CC BT on the side of the pipe, was recovered lying on the ground, loose and out of position with no remains of the stump in which it was set; this position could not be determined or restored.

The geographic position in NAD 1983 (2011)  
 Latitude: 43°23'15.92"N. Longitude: 122°59'21.60"W.

**DECLINATION 14 1/2° E**

**NEW REFS.**

- |                                   |       |                    |
|-----------------------------------|-------|--------------------|
| 5/8" x 30" I.R. / DC50 PLSTC. CAP | PROT. | 8", N64°E, 13° FT  |
| "                                 | "     | 8", S49½°E, 12° FT |
| "                                 | "     | 10", N09°W, 8° FT  |

MONUMENT ON SHALLOW ESE SLOPE IN LARGE BURNED CLEARCUT  
 ≈ 200 FT, S45°E FROM LOGGING SPUR RD.