

GOVERNMENT CORNER RESTORATION FORM

FILED

TOWNSHIP 25S RANGE 2W SEC. 26 PLSS # 52DZZD

Date: 7/24/2023 By: DC

This survey consists of:

Map: _____

DOUGLAS COUNTY OREGON

DATE 7-5-23

Narrative: _____

Corner Rpt: CS67/56-43

Corner Designation

SW 1/16 S26

DOUGLAS COUNTY
SURVEYOR

Monument(s) Found: (Condition and Source)

___ Condition report

2 1/2" BRASS CAP ON 2"

___ Not Found

I.D IRON PIPE UP 8" IN

Renewed

ROUGH STONE MOUND

___ Unrecorded

Previous Renewals

___ Surveyed In

JULIANO 1973 M 51-27

BLM RESURVEY 2010-2011

VOL 57 PG 22806-7

MONUMENT DETAIL

T25S R2W

SW 1/16 S26

1973

Accessories Found

STUMP BURNED ROTTED TO GROUND N 3 1/2° E
6.1 FT R.R. SPIKE & FACE GONE

ROTTED AND BURNED 48" X 2 1/2 FT FIR STUMP
N 70 1/2° E 38.5 FT "W" NAIL AND FACE GONE

BURNED - DEAD 8" FIR S 1 1/2° E 2.4 FT HEALED
HIGH-LOW BLAZE ADD 3 1/2" MAG NAIL RIGHT
SIDE CENTER

BURNED - SAWN 12" X 3/4 FT FIR STUMP
N 46 1/2° W 9.5 FT FACE EVIDENCE INSIDE
STUMP ADD 3 1/2" MAG NAIL TOP CENTER

C.S. File 67/56-43

New Accessories

BURNED - DEAD 12" D. FIR N77°E 15.1 FT
3 1/2" MAG NAIL RIGHT SIDE CENTER TREE
Not BLAZED OR SCRIBED

BURNED - DEAD 26" D. FIR 52°E 15.7 FT
3 1/2" MAG NAIL RIGHT SIDE CENTER TREE
Not BLAZED OR SCRIBED

Sketch of Monument, Accessories, and General Area

Location & Comments

AREA CLEAR CUT EXCEPT
S.E. QUAD


MON ON FLAT GROUND
1/2 MI SOUTH OF
GRAVE ROAD

OCRS STATE PLANE
COORDINATE SYSTEM
COTTAGE GROVE - CANYONVILLE
ZONE

AREA BURNED
9-2020

Comp. Decline. 14 1/2° E
Agency DCSD
Party Chief S. CLAUSE
Note keeper
Witnesses J. FLORES

N 192957.720
E 276973.625

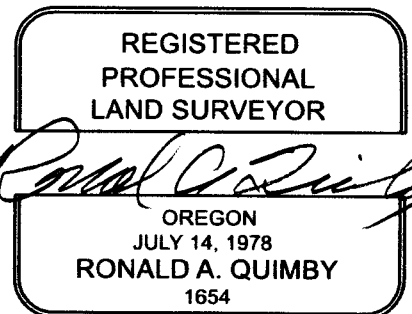

EXPIRES: 12/31/2024

CS 67/56-43

22806

Vol 57

2010-2011

Subdivision of Section 26,
T. 25 S., R. 2 W., Willamette Meridian, Oregon

FEET

from which the remains of bearing trees mkd. by Nick Juliano, Oregon PE No. 3449, in 1973, reported by Berry, Wofford, Popken, and Baughman

A fir snag, 13 ins. diam., bears N. 21 1/2° E., 3.6 ft. dist., with a railroad spike in the face and a healed blaze.

A fir snag, 15 ins. diam., bears S. 1° W., 10.6 ft. dist., with a railroad spike in the face and a healed blaze.

and the remains of bearing trees mkd. by Berry, Wofford, Popken, and Baughman

A sawed fir stump, 14 ins. diam., bears N. 33 1/2° E., 22.1 ft. dist., with fragmentary scribe marks visible on a partially healed blaze.

A fir, 19 ins. diam., bears S. 23 1/2° W., 18.5 ft. dist., with a healed blaze.

and a new bearing tree

A hemlock, 4 ins. diam., bears S. 85 1/4° E., 11.4 ft. dist., mkd. X BT.

From this cor., the 1/4 sec. cor. of secs. 26 and 35 bears S. 89° 29' 22" E., 1322.91 ft. dist.

OCRS CANYONVILLE COTTAGE GROVE COORD.S
192957.720N 276973.625E

N. 2° 40' 01" W., on the N. and S. centerline of the SW 1/4 of sec. 26, posting and blazing. *DECLINATION 14 1/2° E*

The SW 1/16 sec. cor. of sec. 26, established by Nick Juliano, Oregon PE No. 3449, in 1973, and is accepted as the cor., monumented with an iron post, 2 ins. diam., firmly set, projecting 6 ins. above a mound of stone, 2 ft. diam., 6 ins. high, with brass cap mkd.

2 1/2" BC ON 2" I.D.I.P.

✓
T 25 S R 2 W
SW 1/16 S 26
1973

PROT 8" IN AROUGH MOUND OF STONE

from which the remains of bearing trees mkd. by Juliano

STUMP BURNED ROTTEN TO GROUND

A sawed, decayed fir stump, 17 ins. diam., bears N. 3 1/2° E., 6.1 ft. dist., with a railroad spike in the face and no marks visible. ✓

SPIKE AND FACE GONE

BURNED 38" FIR STUMP - TIPPED OUT OF POSITION

A sawed fir stump, 38 ins. diam., bears S. 43 3/4° E., 21.9 ft. dist., with a railroad spike in the face and no marks visible.

and the remains of a bearing tree of unknown origin

ROTTED AND BURNED 48" x 2 1/2 FT

A sawed fir stump, 54 ins. diam., bears N. 70 1/2° E., 38.5 ft. dist., with a "W" nail in the face and no marks visible. ✓ ✓ ✓

W NAIL AND FACE GONE

and new bearing trees

OVER →

CS 67 | 56 - 43

314

*T25S, R2W,
520220*

RENEWED 7/5/23

Subdivision of Section 26,
T. 25 S., R. 2 W., Willamette Meridian, Oregon

FEET	<p><i>BURNED DEAD 8"</i> — A fir, 7 ins. diam., bears S. $1\ 1/2^\circ$ E., 2.4 ft. dist., mkd. SW 1/16 S26 BT. <i>HEALED HIGH-LOW BLZ, ADD 3 1/2" MAG NAIL R.S.C.</i></p> <p><i>BURNED SAWN 12" X 3/4 FT. STUMP</i> A fir, 8 ins. diam., bears N. $46\ 1/2^\circ$ W., 9.5 ft. dist., mkd. X BT. <i>FACE EVIDENCE ADD 3 1/2" MAG NAIL TO CONTR. INSIDE STUMP</i></p> <p>From this cor., the S 1/16 sec. cor. of secs. 26 and 27 bears N. $89^\circ\ 39'\ 28''$ W., 1356.46 ft. dist.</p> <hr/> <p>From the center S 1/16 sec. cor. of sec. 26.</p> <p>N. $89^\circ\ 49'\ 50''$ W., on the E. and W. centerline of the SW 1/4 sec. 26, posting and blazing.</p> <hr/> <p>1355.19 The SW 1/16 sec. cor. of sec. 26.</p> <hr/> <p><i>NEW REF. S</i></p> <p><i>A BURNED DEAD 12" D. FIR WITH A 3 1/2" MAG NAIL R.S.C. BEARS N77°E, 15 1/2 FT.</i></p> <p><i>A BURNED DEAD 26" D. FIR WITH A 3 1/2" MAG NAIL R.S.C. BEARS S02°E, 15 1/2 FT.</i></p> <p><i>BC MONUMENT ON FLAT GROUND ≈ 110 FT. SOUTH FROM GRAVEL RD. AREA CLEARCUT, EXCEPT SE QUAD.</i></p>
------	--