

GOVERNMENT CORNER RESTORATION FORM

FILED

TOWNSHIP 245 RANGE 1W SEC. 32 PLSS # 300/00

Date: 7/24/2023 By: JC

This survey consists of:

Map: _____

Narrative: _____

Corner Rpt: CS67/56-44

DOUGLAS COUNTY OREGON

DATE 7-6-23

DOUGLAS COUNTY SURVEYOR

Corner Designation

T 24-1 32/33
T 25-1 5/4

Monument(s) Found: (Condition and Source)

Condition report

Not Found

Renewed

Unrecorded

Surveyed In

Fd OK Per M 179-9

3-2021

Previous Renewals

MONUMENT DETAIL

Accessories Found

C.S. File 67/56-44

Monument Set (Procedure and Description)

MONUMENT DETAIL

Horizontal lines for Monument Set description.

New Accessories

Horizontal lines for New Accessories description.

Sketch of Monument, Accessories, and General Area

Location & Comments


Area lightly burned, trees found as described in 3/2021

AREA BURNED
9/2020

OCRS State Plane
Coordinate System
Cottage Grove - Canyonville Zone

Comp. Decline. _____
Agency DCSO
Party Chief _____
Note keeper _____
Witnesses _____

N 220 628.759
E 300 241.177

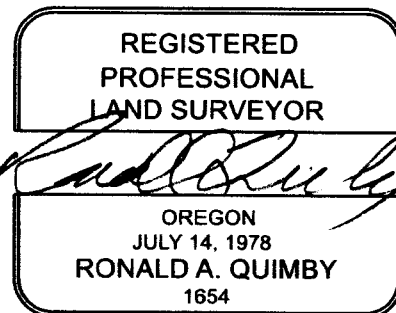

EXPIRES: 12/31/2024

CS 67/56-44
2/4

TOWNSHIP 24 RANGE 01 POINT IDENTIFIER # 300100

PRIMARY CORNER DESCRIPTION Sec Cor for 32 & 33; 4 & 5, T25-1

Alias _____	Description _____
Alias _____	Description _____
Alias _____	Description _____
Alias _____	Description _____

Russell Badgley - For: Seneca Jones Timber Co. - 3/2021 - M179-9

AREA
LIGHTLY BURNED
TREES FOUND
AS DESCRIBED
IN 3/21

Found - A 1" iron post by Godfrey, firmly set and projecting 5" above the ground, with a 2½" brass cap (properly) mkd from which

A 19" D.Fir bears S.23°00'W., 22.7 ft w/healed (S.24°W., 22 9') 1962

A 19" D.Fir bears N.20°15'W., 14.4 ft w/healed (N.20°W., 14.7') 1962

A Hemlock snag (D.Fir) 1962, bears N.48°30'E., 24.0 ft w/healed blaze (N.45°E., 23.2') 1962

New BTs- A 17" Cedar bears N.69°45'W., 34.8 ft scribed "T24S R1W S32 BT" on double blaze

A 20" D.Fir bears N.88°45'E, 14.1 ft scribed "T24S R1W S33 BT" on double blaze

CS 67156-44

MN GPS 7/6/23 N 220628.759
TIME - 12:45 E 300241.177
HI - 2.990M

TOWNSHIP 24 RANGE 01 POINT IDENTIFIER # 300100

PRIMARY CORNER DESCRIPTION Sec Cor for 32 & 33; 4 & 5, T25-1

Alias _____ Description _____
Alias _____ Description _____
Alias _____ Description _____
Alias _____ Description _____

GLO survey by Carl S. Nicklin, Deputy Surveyor, under joint contract #664 dated May 23, 1896 (DCSO records Vol. 7 Page(s) 2778)

Set a Fir post 4 ft. long, 4" sq., 24" in the ground for cor. of 33, 4, 5, and 32, marked T24S S33 on NE.; R1W S4 on SE.; T25S S5 on SW.; and S32 on NW. faces, with 2 notches on W. and 4 notches on E. edges; from which
A Fir 8" dia., bears N.60°E., 8 lks. dist. mkd. T24S R1W S33 BT.
A Fir 24" dia., bears S.10°E., 51 lks. dist. mkd. T25S R1W S4 BT.
A Fir 12" dia., bears S.51½°W., 6 lks. dist. mkd. T25S R1W S5 BT.
A Fir 12" dia., bears N.44°W., 28 lks. dist. mkd. T24S R1W S32 BT.
Cor. is on a hillside, sloping N. about 100 ft. above creek.

Douglas Co. Surveyors Office - Milo E. Godfrey, Deputy - Vernon Tracy; M. Stone, crew - Aug. 1962 - C.S. File 52/42-23

Found - New 4" x 4" Cedar stake at corner.
Fir now 34", S.10°E., 33.7 ft., shows 2 good axe scars.
Fir tree, uprooted and down, S.51½°W., 4.0 ft., opened scar and found good scribing "SR".
Fir tree, uprooted and down, N.60°E., 5.3 ft., shows good scar.
Fir tree, uprooted and down, N.44°W., 18.5 ft., shows good scar.

Set Brass cap at cor. mkd: County Surveyors Office
T24S S 32 | S 33 T25S R1W
S 5 | S 4
1962

New BTs- 16" D.Fir S.24°W., 22.9 ft. mkd. T25S R1W S5 CS BT.
11" D.Fir N.20°W., 14.7 ft. mkd. T24S R1W S32 CSBT
8" D.Fir N.45°E., 23.2 ft. mkd. T24S R1W S33 CS BT

Fd. OK, DCSO, V.R. Tracy - May 1970 C.S. File 54/27-193

Fd. OK and used in BLM resurvey by James E. Jelley, Cadastral Surveyor, Group #'s 350 & 929, Surveyed May 1978/May 1980 - (DCSO records Vol. 42 Page(s) 16339)

continued next page

CS 67/54-44 1
414