

GOVERNMENT CORNER RESTORATION FORM

FILED

TOWNSHIP 25S RANGE 1W SEC. 4 PLSS # 340640

Date: 7/24/2023 By: X

This survey consists of:

DOUGLAS COUNTY OREGON

DATE 7-10-23

Map: _____

Narrative: _____

Corner Rpt: CS 67/56-46

Corner Designation

C 1/4 S 4

DOUGLAS COUNTY SURVEYOR

Monument(s) Found: (Condition and Source)

BLM BRASS CAP
up 4"

Condition report

Not Found

Renewed

Unrecorded

Surveyed In

Previous Renewals

Shrum 1964 M32-62
BLM Resurvey 1978-1980
Vol 42 Pg 16354
Nygren 2017 M 173-75

MONUMENT DETAIL

T25S R1W
C 1/4 S 4
1978

Accessories Found

13" Fir N 84° E 3.6 FT GOOD SCAR
22" Hemlock N 72 1/2° W 49.8 FT GOOD SCAR

1/2" Iron pipe with Alum Cap N 71 1/4 W
33.0 FT MARKED T25S R1W S 1/4 S 4 1964

BEARINGS AND DIST. NOT CHECKED DUE
TO WINDFALL AND BRUSH

C.S. File 67/56-46

RENEWAL

Monument Set (Procedure and Description)

MONUMENT DETAIL

New Accessories


Sketch of Monument, Accessories, and General Area

Location & Comments

LAT 217874.442
LONG 300108.965

AREA BURNT
9-2020

Comp. Decline. 14 1/2° E
Agency DCSO
Party Chief S Fause
Note keeper
Witnesses J Florsung

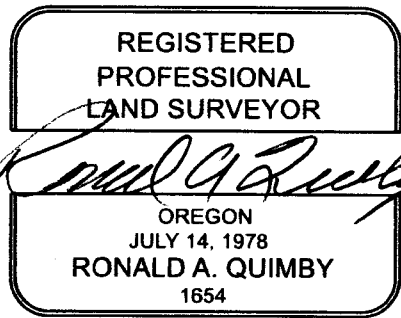

EXPIRES: 12/31/2024

CS 67/56-46

2

FND. OK 7/10/23

TOWNSHIP 25 RANGE 01 POINT IDENTIFIER # 340640

PRIMARY CORNER DESCRIPTION Center 1/4 Cor Sec 4

Alias _____	Description _____
Alias _____	Description _____
Alias _____	Description _____
Alias _____	Description _____

Thomas Shrum, Jr. - For: US Plywood Cor. - Nov. 1966 - M32-63

Set - 2 1/2" dia., alum. cap.
 15" W. Pine stump S. 56 1/2° E., 18.3 ft.
 13" D. Fir stump N. 88° W., 15.0 ft.

BLM Dependent resurvey by James E. Jelley, Cadastral Surveyor under Group #350 & 929 surveyed May 1978/May 1980 - (DCSO records Vol. 42 Page(s) 16354)

Point for center 1/4 sec. cor. of sec. 4, at intersection with the E & W center line.

Set an iron post, 28" long, 2 1/2" dia., 24" in the ground, with brass cap marked:

T25S R1W
C 1/4 S 4
1978
PROT 4"

from which

- 13" — A fir, 8" dia., bears N. 84° E., 5 1/2 lks., mkd: C 1/4 S4 BT.
 - 22" — A hemlock, 10" dia. bears N. 72 1/2° W., 75 1/2 lks. mkd: C 1/4 S4 BT
- From this point, a corner established by Shrum in 1954, bears N. 71 1/4° W., 0.50 chs., monumented with an iron post 1 1/2" dia., firmly set, projecting 10" above ground, with primum cap mkd. T25S R1W S 1/4 Sec 4 1964, from which the remains of a bearing tree mkd. by Shrum:
- A sawed fir stump, 20" dia., bears N. 88 1/4° W., 22 1/2 lks., with fragmentary scribe marks visible in open place.

Fd. as per 1978 BLM survey 11/20/77 by G. Nygren

**B'S AND D'S NOT CHK'D
AND NO GPS POSITION GOTTEN
DUE TO FALLEN TREES AND BRUSH AT LOCATION**

CS 67/56-46
3/3