

GOVERNMENT CORNER RESTORATION FORM

FILED

TOWNSHIP 245 RANGE 1W SEC. 232 PLSS # 240 146

Date: 7/24/2023 By: X
This survey consists of:

DOUGLAS COUNTY OREGON

DATE 7-11-23

Map: _____

Narrative: _____

Corner Rpt: CS 67/56-48

Corner Designation

C/A: S 32

DOUGLAS COUNTY
SURVEYOR

Monument(s) Found: (Condition and Source)

5/8" I. Rod with yellow
Plastic Cap projecting 4" above
Ground

Condition report

Not Found

Renewed

Unrecorded

Surveyed In

Previous Renewals

Nygren 2016 M 172-62
BADgley 2021 M 179-9

MONUMENT DETAIL

Accessories Found

<u>13" D. FIR</u>	<u>N 30°W</u>	<u>13.6 FT</u>	<u>GOOD</u>	<u>SCAR</u>
<u>19" D. FIR</u>	<u>N 38°E</u>	<u>22.5 FT</u>	<u>"</u>	<u>"</u>
<u>9" D FIR</u>	<u>S 29°E</u>	<u>23.4 FT</u>	<u>"</u>	<u>"</u>
<u>20" D FIR</u>	<u>S 41°W</u>	<u>22.1 FT</u>	<u>"</u>	<u>"</u>

GALVANIZED Post North 33 FT

C.S. File 67/56-48

RENEWAL

Monument Set (Procedure and Description)

MONUMENT DETAIL

New Accessories


Sketch of Monument, Accessories, and General Area

Location & Comments

LAT 223340.246
 LONG 297620.951

AREA BURNT
 9-2020

Comp. Decline. 14 1/2° E
 Agency DCSP
 Party Chief S. F. LAUSE
 Note keeper
 Witnesses J. LORSUNA

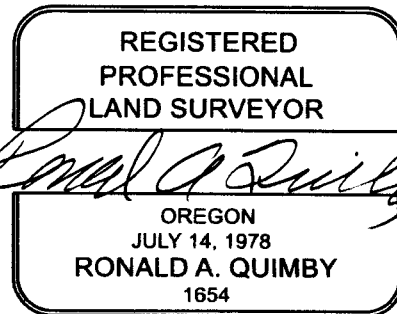

EXPIRES: 12/31/2024

CS 67/56-48

MMGPS 1/11/23
TIME - 12:00
H.I. - 2.000

FND. OK 7/11/23

TOWNSHIP 24 RANGE 01 POINT IDENTIFIER # 240140

PRIMARY CORNER DESCRIPTION Center 1/4 Cor. Sec. 32

Alias _____	Description _____
Alias _____	Description _____
Alias _____	Description _____
Alias _____	Description _____

<p>Gerald V. Nygren - For: Barnes & Assoc. Inc. - 11/2016 - M172-62</p> <p>-----</p> <p>Set - 5/8" x 30" iron rod with yellow plastic cap mkd "NYGREN PLS 1035"</p> <table border="0" style="width: 100%;"> <tr> <td style="width: 150px;">13" 11" D.Fir bears N.30°W., 13.6'</td> <td>scribed: "C ¼ S32 BT"</td> <td style="text-align: right;"><i>PART. SCRIB. VIS. PHDB</i></td> </tr> <tr> <td>19" 17" D.Fir bears N.38°E., 22.5'</td> <td>scribed: "C ¼ S32 BT"</td> <td style="text-align: right;">"</td> </tr> <tr> <td>9" 8" D.Fir bears S.29°E., 23.4'</td> <td>scribed: "C ¼ S32 BT"</td> <td style="text-align: right;">"</td> </tr> <tr> <td>20" 18" D.Fir bears S.41°W., 22.1'</td> <td>scribed: "C ¼ S32 BT"</td> <td style="text-align: right;">"</td> </tr> </table>	13" 11" D.Fir bears N.30°W., 13.6'	scribed: "C ¼ S32 BT"	<i>PART. SCRIB. VIS. PHDB</i>	19" 17" D.Fir bears N.38°E., 22.5'	scribed: "C ¼ S32 BT"	"	9" 8" D.Fir bears S.29°E., 23.4'	scribed: "C ¼ S32 BT"	"	20" 18" D.Fir bears S.41°W., 22.1'	scribed: "C ¼ S32 BT"	"
13" 11" D.Fir bears N.30°W., 13.6'	scribed: "C ¼ S32 BT"	<i>PART. SCRIB. VIS. PHDB</i>										
19" 17" D.Fir bears N.38°E., 22.5'	scribed: "C ¼ S32 BT"	"										
9" 8" D.Fir bears S.29°E., 23.4'	scribed: "C ¼ S32 BT"	"										
20" 18" D.Fir bears S.41°W., 22.1'	scribed: "C ¼ S32 BT"	"										
<p>Russell Badgley - For: Seneca Jones Timber Co. - 3/2021 - M179-9</p> <p style="text-align: center;"><i>4"</i></p> <p>-----</p> <p>A 5/8" iron rod by Nygren in 2016 per M172-62, firmly set and projecting 2" above the ground, with a yellow plastic cap per the record. Accessories in good condition. <i>GALVANIZED STEEL LATH 3 FT NORTH</i></p>												

CS 67/56-48
3/3