

GOVERNMENT CORNER RESTORATION FORM

TOWNSHIP 24S RANGE 1W SEC. 29 PLSS # 240200

FILED
Date: 8/2/2023 By: X
This survey consists of:

DOUGLAS COUNTY OREGON

DATE 7-24-23

Map: _____
Narrative: _____
Corner Rpt: CS 67/56-49

Corner Designation

1/4 COR 29
32

DOUGLAS COUNTY
SURVEYOR

Monument(s) Found: (Condition and Source)

2 1/2" County Surveyor
OFFICE BRASS CAP
UP 19" IN Rough Stone MOUND

___ Condition report
___ Not Found
 Renewed
___ Unrecorded
___ Surveyed In

Previous Renewals

DCSO 1960 CS 52/42-1
DCSO 1970 CS 54/27-190
DCSO 1996 CS 65/9-20

MONUMENT DETAIL

28" Hemlock S 86° W 40.8' Healed Face

Accessories Found

22" D. Fir S 15 1/2° W 16.4 FT (REC 16.7 FT)
Fully Healed Double BLAZE ADD 3 1/2" MAG
NAIL RIGHT Side Center
28" Hemlock S 86° W 40.8 FT Healed FACE

18" D. Fir N 70° W 9.7 FT Fully Healed
Double BLAZE ADD 3 1/2" MAG NAIL RIGHT
Side Center

17" D. Fir N 50° 30' E 53.2 FT Fully Healed
Double BLAZE ADD 3 1/2" MAG NAIL
RIGHT Side Center

35" X 2" Tall D. Fir Stump S 37° W 20.8 FT
DIST. AND BEARING TO FACE OF Stump

C.S. File 67/56-49

Monument Set (Procedure and Description)

MONUMENT DETAIL

Blank lines for Monument Set (Procedure and Description)

New Accessories

Blank lines for New Accessories

Sketch of Monument, Accessories, and General Area

Location & Comments


mon. in large second growth
fir on moderate east slope
OCRS coordinate system
Cottage Grove - Canyonville
zone

corner is approx
20' west of abandoned
N-S grade road

AREA BURN
9/2020

N 225987.123
E 297656.983

Comp. Decline. 14 1/2° E
Agency DCSO
Party Chief S. Fause
Note keeper
Witnesses J. Loring

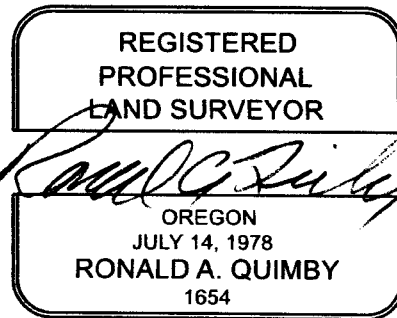

CS 67/56-49 2/3

NOT MM GPS 7/12/23 TIME - 10:45
225987.123N H.I. - 2.000M.

RENEWED 7/24/23

TOWNSHIP 24 RANGE 01 POINT IDENTIFIER # 240200

OCRS CANYONVILLE COTTAGE GROVE COOP. S

PRIMARY CORNER DESCRIPTION 1/4 Cor. Secs. 29 & 32

Alias _____	Description _____
Alias _____	Description _____
Alias _____	Description _____
Alias _____	Description _____

New - ^{22"} 11" D. Fir, double blazed and scribed "1/4 S32 CS BT" bears S.15 1/2° W., ~~16.7~~ ^{16.4} Ft. **FHDB** **ADD 3 1/2" MAG NAIL R.S.C.**

7" D. Fir, double blazed and scribed "1/4 S29 CS BT" bears N.70° W., 9.7 ft.

6" D. Fir, double blazed and scribed "1/4 S29 CS BT" bears N.50 1/2° E., 53.2 ft.

Note - Corner lies approx. 25 ft. west of a gravel road.

Gerald V. Nygren - For: Barnes & Assoc. Inc. - 11/2016 - M172-62

2 1/2 BC PROT. 14" ADD ROUGH MOUNDS OF STONE

Found - 1960 C.S. brass cap per PLSS 240200

28" (1970) 8" Hemlock, now 25" bears S.86° W., 40 1/8' healed face

18" (1996) 7" D. Fir, now 15" bears N.70° W., 9.7' healed face. **FHDB** **ADD 3 1/2" MAG NAIL R.S.C.**

17" 6" D. Fir, now 11" bears N.50° 30' E., 53.2' healed face **FHDB** **2 FT. TALL**

(No record) 35" D. Fir stump with tag dated 2/18/81 bears S.37° W., 20.8' distance and bearing to face of stump agree with tag.

MONUMENT IN LARGE SECOND GROWTH FIR ON MODERATE EAST SLOPE APPROX. 20 FT WEST FROM ABANDONED N-S GRAVEL RD.