

GOVERNMENT CORNER RESTORATION FORM

FILED

TOWNSHIP 24S RANGE 1W SEC. 28 PLSS # 320220

Date: 8/2/2023 By: SC

This survey consists of:

DOUGLAS COUNTY OREGON

DATE 7-26-23

Map: _____

Narrative: _____

Corner Rpt: CS 67/56-52

Corner Designation

SW 1/16

DOUGLAS COUNTY
SURVEYOR

Monument(s) Found: (Condition and Source)

2 1/2" Alum CAP

___ Condition report

___ Not Found

Renewed

___ Unrecorded

___ Surveyed In

Previous Renewals

Shrum 1967 m 36-13

Shrum 1972 m 50-44

MONUMENT DETAIL

T24S R1W

SW 1/16

S 28

RE 4287

Accessories Found

Rotted Broken 30" X 2FT FIR STUMP
N 62°W 7.6 FT

C.S. File 67/56-52

New Accessories

10" D. FIR S 34° E 4.5 FT 3 1/2" MAG NAIL
RIGHT Side Center

10" D. FIR S 51° W 7.0 FT 3 1/2" MAG NAIL
RIGHT Side Center

Sketch of Monument, Accessories, and General Area

Location & Comments


OCRS coordinate system
Cottage Grove Canyonville
zone

Cor 15 approx 50 FT
N/E OF SELLY RUNNING
GRAVEL ROAD IN OLDER
D. FIR REPROD

N 227322.300
E 301584.293

Area BURNT
9/2020

Comp. Decline. 14 1/2° E
Agency DCSO
Party Chief S. F. Aulse
Note keeper
Witnesses J. LORSUNY

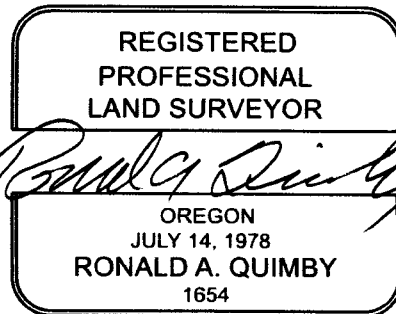

EXPIRES: 12/31/2024

CS 67/56-52

Fd.: 2 1/2" Al. Cap
Hem. 10", N 06° E, 6.0'

C-W 1/16 Cor.

S 88° 45' 54" E

1329.31

1363.32

Fd.: Original Stone
D. Fir 60", N 40° E

1363.32'

Set: 2 1/2" Al. Cap
Hem. 18", S 37 1/2° E, 17.8'
D. Fir 30", S 87° W, 2.8'
Hem. 8", N 19° 30' W, 38.7'

N 0° 29' 54" E
1299.95'

1289.96'

N 01° 56' 56" E
1304.08'

RENEWED 7/26/23 T245 R1W 320220

S 89° 11' 37" E

SW 1/16 Cor. 1323.79' RAIP PROT. 3"

Fd.: 2 1/2" Al. Cap
NEW ROTTED D. FIR 36" N 62° W, 7.6'
BROKEN 30" X 2 FT. STUMP

1335.96'

S 89° 09' 41" E

SE 1/16 Cor

Fd.: 2 1/2" Al. Cap
D. Fir 18", N 17° E, 360'

T245 R1W
SW 1/16
528
RF 4287

DECLINATION 14 1/2° E
NEW

OCCAS CANYONVILLE COTTAGE GROVE
COOKS
N
E

10" D. FIR 3 1/2" MAG NAIL R.S.C. BEARS S 34° E, 4 1/2 FT
10" D. FIR " " BEARS S 51° W, 70 FT

O S 1/4 Cor.

Fd.: Brass Cap
D. Fir 24", S 08° W, 16.8'
D. Fir 20", N 41 1/2° E, 11.7'

MONUMENT IS APPROX 50 FT.
NE OF SE'LY RUNNING GRAVEL RD.
IN OLDER D. FIR REFRPOD

Wayne
1999

CS 58/8-20

~~MA 36/43~~

MA 50-44

~~MA 50-44~~

CS 67 | 56 - 52
3/3