

GOVERNMENT CORNER RESTORATION FORM

FILED

TOWNSHIP 25S RANGE 1W SEC. 4

PLSS # 300600 Date: 8/30/2023 By: S  
This survey consists of:

DOUGLAS COUNTY OREGON

DATE 8-8-23

Map: \_\_\_\_\_

Narrative: \_\_\_\_\_

Corner Rpt: C567/5654

Corner Designation

N 1/4 55/54

DOUGLAS COUNTY  
SURVEYOR

Monument(s) Found: (Condition and Source)

BLM BRASS CAP BURIED  
below ROAD SURFACE Good  
MAG Reading Not dug up

Previous Renewals

BLM RESURVEY 1978 Vol 142  
pg 16346

- Condition report
- Not Found
- Renewed
- Unrecorded
- Surveyed In

MONUMENT DETAIL

Accessories Found

3/4" BRASS CAP N 53°E 49.8 FT FLUSH  
with SURFACE in mound of stone MARKED  
N 1/4 54 RM 1978 with ARROW pointing  
TO CORNER

3/4" BRASS CAP N 66 3/4°W 92.4 FT  
(REC N 56 3/4°W) in mound of stone  
MARKED N 1/4 55 RM 1978 with ARROW  
pointing TO CORNER

C.S. File 67/56-54  
13

\_\_\_\_\_  
\_\_\_\_\_  
New Accessories

ADD LINE CROSSING TAG TO 11" D. FIR  
NORTH 22± FT

\_\_\_\_\_  
\_\_\_\_\_  
Sketch of Monument, Accessories, and General Area


Location & Comments

OCRS COORDINATE SYSTEM  
COTTAGE GROVE - CANYONVILLE  
ZONE

AREA BURNED  
9/2020

N 219239.132  
E 300179.971

Comp. Decline 14 1/2° E  
Agency DCSO  
Party Chief S. F. HAUSE  
Note keeper  
Witnesses J. LORSUNG

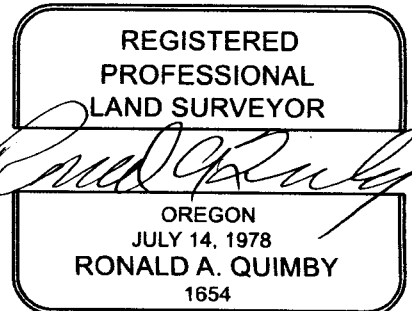

EXPIRES: 12/31/2024

CS 67/56-54 213

356T 25S, R. 1 W., 300660

RENEWED 8/8/23

Dependent Resurvey, Portion of Subdivisional Lines,  
T. 25 S., R. 1 W., Willamette Meridian, Oregon

OOR'S CANYONVILLE COTTAGE GROVE COORDS

219239.132 N  
300179.971 E

GOOD MAG, SIGNAL NOT UNCOVERED

N 1/16  
S 5/8 4  
1978

DECLINATION 14 1/2° E

from which

3/4" BC MARKED AS DESCRBD.

An iron post, 28 ins. long, 2 1/2 ins. diam., set 24 ins. in the ground, and in a mound of stone, 3 ft. base, to top, for a reference monument, bears N. 53° E., 75 1/2 lks. dist., with brass cap mkd. N 1/16 S4 RM/1978 and an arrow pointing to the corner.

49 E V BC NOW MORE OR LESS FLUSH WITH SURFACE IN ROUGH MOUND OF STONE

An iron post, 28 ins. long, 2 1/2 ins. diam., set 24 ins. in the ground, and in a mound of stone, 3 ft. base, to top, for a reference monument, bears N. 56° W., 140 lks. dist., with brass cap mkd.

BEARING IN ERROR SHOULD BE N 66 3/4 W

N 1/16 S5 RM/1978 and an arrow pointing to the corner.

92 E V ALSO NOW SITUATED AS MON. DESCRIBED ABOVE

NEW REF.

ADD LINE CROSSING TAG TO 11" D. FIR NORTH, ~ 22 FT. DISTANT

70.00

Ascend 335 ft. over S. slope.

Ridge, bears E. and W.; desc. 75 ft. over NW. slope.

83.21

The cor. of secs. 4, 5, 32, and 33.

Land, mountainous.  
Soil, rocky clay.  
Timber, fir, hemlock, cedar, maple, oak, madrone, alder, and chinquapin; undergrowth, salal, Oregon grape, vine maple, rhododendron, poison oak, and fern.

From the 1/4 sec. cor. of secs. 31 and 32, monumented with the original basalt stone, 18 x 10 x 8 ins., loosely set 6 ins. in the ground, and in a mound of stone, 3 ft. base, 1 ft. high, mkd. 1/4 on W. face, from which the remains of an original bearing tree:

A root hole, bears N. 52° E., 44 lks. dist., with a down chinquapin alongside, size indeterminate, no marks visible.

and the remains of a bearing tree of which I have no record

A fir snag, 25 ins. diam., bears S. 4 1/2° W., 74 lks. dist., with fragmentary scribe marks visible on open and burned blaze.

At the corner point

Set an iron post, 28 ins. long, 2 1/2 ins. diam., 20 ins. in the ground, in a mound of stone, 3 ft. base, to top, with brass cap mkd.

567/56-54  
3/3