

GOVERNMENT CORNER RESTORATION FORM

FILED

TOWNSHIP 26S RANGE 2W SEC. 5 PLSS # 200640

Date: 8/30/03 By: X
This survey consists of:

DOUGLAS COUNTY OREGON

DATE 8-15-23

Map: _____

Narrative: _____

Corner Rpt: CS 67/56-55

Corner Designation

1/4 COR 56/55

DOUGLAS COUNTY
SURVEYOR

Monument(s) Found: (Condition and Source)

3 1/2" BLM BRASS CAP
IN ROUGH STONE MOUND

UP 11"

Previous Renewals

BLM RESURVEY 1959 Vol 30 pg 12752

WEYERHAEUSE 1975 CS 59/8-19

DCSO 1976 CS 59/8-19

DCSO 1981 CS 61/29-42

___ Condition report

___ Not Found

Renewed

___ Unrecorded

___ Surveyed In

MONUMENT DETAIL

T26S R2W

1/4

56/55

1959

Accessories Found

48" X 2 FT BURNED-SAWN FIR STUMP N 64 1/2° W
17.5 FT (REC N 61° W 14.6 FT) ADD 3 1/2" MAG
NAIL TOP CENTER

62" X 20 FT BURNED BROKEN OF FIR STUMP
N 64° E 36.3 FT (REC N 65° E 34.2 FT)

14" Hemlock NSW 14.7 FT Fully Healed
DOUBLE BLAZE ADD 3 1/2" MAG NAIL RIGHT
SIDE CENTER

11" X 14 FT Broken Burnt Hemlock SW AG
S 26 1/2° E 25.1 FT

C.S. File 67/56-55

New Accessories

6" X 2 FT SAWN BURNED FIR STUMP
S20°W 39.5 FT 3 1/2" MAG NAIL TOP
Center

Sketch of Monument, Accessories, and General Area

Location & Comments

MON. ON NEARLY FLAT GROUND
ON N-S. CUTLINE OLD GROWTH
EAST CLEAR CUT WEST


MON. 90'± EAST
FROM GRAVEL SPUR
ROAD

AREA BURNED
9-2020

O C R S

N 183247.027
E 206421.614

Comp. Decline. 14 1/2° E
Agency DCSD
Party Chief S. FHOUSE
Note keeper
Witnesses J. LORSONG

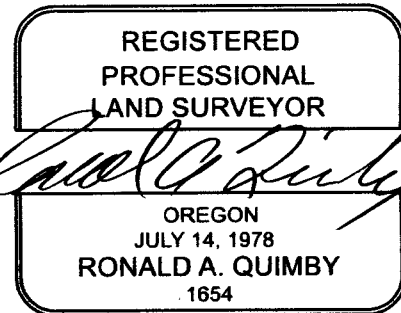

EXPIRES: 12/31/2024

8/15/23

TOWNSHIP 26 RANGE 02 POINT IDENTIFIER # 200640

PRIMARY CORNER DESCRIPTION 1/4 Cor. Secs. 5 & 6

Alias _____	Description <u>OCRS CANYONVILLE COTTAGE GROVE CORNERS</u>
Alias _____	Description _____
Alias _____	Description <u>183247.027 N</u>
Alias _____	Description <u>260427.614 E</u>

Frank O. Williams - For: Weyerhaeuser Co. - May 6, 1975 - C.S. File 59/8-19

Vicinity of 1/4 Cor. Secs. 5 & 6

Found - 12" Hemlock, scribing visible, N.42°E., 8.9 ft.
 20" Swell butt Hemlock, scribing visible S.46°E., 20.1 ft.
 72" Fir, scribing visible, put Weyerhaeuser plate at base of tree, tree to be felled. S.51°W., 7.3 ft.
 30" Fir, N.46°W., 25.1 ft. Tree felled, Weyerhaeuser plate at base of stump.

Weyerhaeuser plates are marked with 1959 GLO distances & reciprocal bearings.

NOTE - The GLO 1/4 cor. for secs. 5 & 6, a 1959 GLO brass cap with 2 BTs is South 4.00 chs.

Douglas Co. Surveyors Office - Gary L. Langlitz - A. Vic Cangie - 4/19/1976 - C.S. File 59/8-19

(This report is attached to the 1975 Weyerhaeuser report) Information of Unknown origin.

We find the trees mentioned in the attached Weyerhaeuser notes.

This information is also recorded in the 1959 Government resurvey notes on the section line between sections 5 & 6. There is no monument at this corner and no record of these apparent bearing trees.

We do not monument this corner.

DECLINATION 14 1/2° E

Douglas Co. Surveyors Office - Gregory E. Quibell, Deputy - Teresa Buley, witness - Dec. 9, 1981 - C.S. 61/29-42

3 1/2" BC MON. DESCRIBED 1959 - PROF H" IN ROUGH MOUND STONE
(Reference notes C.S. 59/30 now attached to this renewal.)

Found - 1959 BLM B.C., firmly set in mound of rocks, (Ref. notes) properly marked. Also, see 1975 Ren. *64 1/2*

BTs *2 FT* x 48" Fir w/w nail per Ref. notes, bears N. *61 W.*, 14.6 ft. *gone*. Tree alive & well, shows good *scar gone* scar. *17 1/2* ADD 3 1/2" MAG NAIL TOP CNTR.

36 1/2 22" Cedar stump w/scribed "1/4 S5 BT" visible as per Ref. notes, bears S.41°E., 10.6 ft. *64°*

62" x 20 FT Fir w/w nail per Ref. notes, bears N. *63 E.*, 34.2 ft. *gone* nail. Tree alive & well.

New BTs- 14" Hemlock scribed "1/4 S6 CS BT" in dbl. blaze bears *FHDB* N.5°W. 14 *1/2*". ADD 3 1/2"

11" x 14 FT Hemlock scribed "1/4 S5 CS BT" in dbl. blaze bears S.26°E., 25 *1/2* ft.

Note - See C.S. 61/29 for sketch & Ref. notes.

BURNED SAWN OFF STUMP

BURNED BROKEN OFF

BURNED BROKEN SNAG

SAWN BURNED

NEW REF FIR STUMP

6" x 2 FT, 3 1/2" MAG NAIL TOP CENTER BEARS S20°W, 39.5 FT

BC MON. ON NEAR FLAT GROUND, ON N-S CUTLINE BURNED OLD GROUND EAST, CLEAR CUT WEST

BC MON. ~ 90 FT. EAST FROM GRAVEL SPUR RD.

6756 55 213