

TOWNSHIP 26S RANGE 2W SEC. 8 PLSS # 240500

Date: 8/30/2023 By: X  
This survey consists of:

DOUGLAS COUNTY OREGON

DATE 8-21-23

Map: \_\_\_\_\_

Narrative: \_\_\_\_\_

Corner Rpt: CS 67/56-58

DOUGLAS COUNTY  
SURVEYOR

Corner Designation

E 1/16 58  
517

Monument(s) Found: (Condition and Source)

3 1/4" BLM BRASS CAP  
4p 4"

\_\_\_ Condition report

\_\_\_ Not Found

Renewed

\_\_\_ Unrecorded

\_\_\_ Surveyed In

Previous Renewals

BLM Resurvey 1959 Vol 30 pg 12747  
HOFFINE 2016 M 172-7

MONUMENT DETAIL

Ramsey CS 51/86

E 1/16 58  
517  
1959

Accessories Found

Burned - Dead 42" D. FIRE S52°E 86.4 FT  
Healed FACE ADD 3 1/2" MAG NAIL Right  
Side Center

BURNED - SAWN 13" X 7 FT D. FIRE STUMP  
N 42 1/2° E 16.3 FT (Rec N 72 1/2° E) PARTLY HEALED  
SINGLE BLAZE ILLEGIBLE SCRIBES VISIBLE

Monument Set (Procedure and Description)

MONUMENT DETAIL

Horizontal lines for Monument Set (Procedure and Description)

New Accessories

Horizontal lines for New Accessories

Sketch of Monument, Accessories, and General Area

Location & Comments

OCRS COORDINATE SYSTEM  
Cottage Grove - Canyonville  
Zone

N 175108.013  
E 264336.992

AREP BURNT  
9-2020  
COR IS ± 35'  
SOUTH OF ROAD  
Comp. Decline. 14'50" E  
Agency DCSO  
Party Chief S. FIAUSE  
Note keeper  
Witnesses J. FORSUNDY

REGISTERED  
PROFESSIONAL  
LAND SURVEYOR

*Ronald A. Quimby*

OREGON  
JULY 14, 1978  
RONALD A. QUIMBY  
1654

EXPIRES: 12/31/2024

CS 67/56-58  
214

Monument Set (Procedure and Description)

MONUMENT DETAIL

Horizontal lines for Monument Set description.

New Accessories

Horizontal lines for New Accessories description.


Sketch of Monument, Accessories, and General Area

Location & Comments

CCRS COORDINATE System  
Cottage Grove - Canyonville  
Zone

N 175108.013  
E 264336.992

AREA BURNT  
9-2020  
COR IS  $\approx$  35'  
SOUTH OF ROAD  
Comp. Decline. 14<sup>1/2</sup>° E  
Agency DCSO  
Party Chief S. F. Hulse  
Note keeper  
Witnesses J. LORSUNY

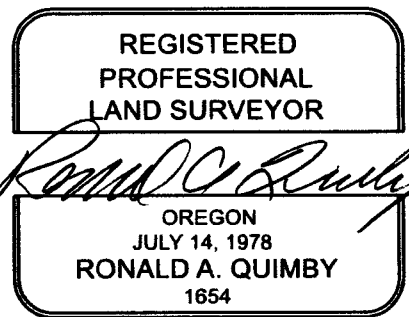

EXPIRES: 12/31/2024

CS 67/56-58  
214

AY 2016

CORNER INFORMATION:

1) THE QUARTER CORNER BETWEEN SECTIONS 8 AND 9 GCDB 300540  
 FOUND 1959 BLM BRASS CAP 0.8 FEET ABOVE GROUND  
 - 12" DOUGLAS FIR BEARS N77°E 17.9 FEET (RECORD N75°E 19.14 FEET) HEALED FACE AND BLM TAG  
 - 36" DOUGLAS FIR BEARS N68 1/4°W 29.9 FEET (RECORD N70°W 29.37 FEET) HEALED FACE AND BLM TAG  
 CORNER LIES ON NORTH FACING SLOPE IN MOUND OF STONES

2) THE SOUTH 1/16TH CORNER BETWEEN SECTIONS 8 AND 9 GCDB 300520  
 FOUND 1959 BLM BRASS CAP 0.2 FEET ABOVE GROUND  
 - 25" DOUGLAS FIR BEARS S60 1/2°E 21.4 FEET (RECORD S61 1/2°E 21.78 FEET) HEALED FACE AND TAG  
 - 12" FIR SNAG BEARS S62 1/2°W 5.6 FEET (RECORD S58 1/2°W 5.61 FEET) HEALED FACE AND BLM TAG  
 - 8" DOUGLAS FIR BEARS S71 1/2°W 25.2 FEET WE SCRIBE S 1/16 S8 BT AND TAG TREE  
 CORNER LIES ON SOUTHEAST SLOPE WITH LARGE BLM TIMBER TO EAST.

3) THE SOUTHEAST SECTION CORNER FOR SECTION 8 GCDB 300500  
 FOUND 1918 USGLO BRASS CAP 1.0 FEET ABOVE GROUND  
 - 67" DOUGLAS FIR BEARS N41°E 19.4 FEET (RECORD N40°E 18.48 FEET) HEALED FACE AND BLM TAG  
 - 38" DOUGLAS FIR BEARS S20 1/4°E 7.7 FEET (RECORD S20°E 6.8 FEET) HEALED FACE AND BLM TAG  
 - 53" DOUGLAS FIR BEARS S54°W 25.4 FEET (RECORD S55°W 25.74 FEET) HEALED FACE AND BLM TAG  
 - 14" CHINQUAPIN BEARS N74 1/4°W 10.55 FEET (RECORD N75 1/4°W 10.56 FEET) HEALED FACE AND BLM TAG  
 CORNER LIES ON EAST FACING SLOPE IN HEAVY HUCKLEBERRY BRUSH

*FOUND OK 8/21/23  
 T265, R02W, 260500*

*BURNED DEAD 42"  
 GONE  
 BURNED SAWN STUMP  
 13" X 7 FT TALL*

4) THE EAST 1/16 TH CORNER BETWEEN SECTIONS 8 AND 17 GCDB 260500  
 FOUND 1959 BLM BRASS CAP 0.7 FEET ABOVE GROUND  
 - 40" DOUGLAS FIR BEARS S52°E 16.4 FEET (RECORD S51 1/4°E 16.42 FEET) HEALED FACE AND BLM TAG  
 - ROTTEN FIR STUMP BEARS N84°E 49.7 FEET (RECORD N84 1/2°E 50.16 FEET) NO VISIBLE MARKS  
 - 13" DOUGLAS FIR BEARS N72 1/2°E 16.3 FEET WE SCRIBE E1/16 S8 BT AND TAG TREE  
 CORNER LIES ON SOUTHWEST SLOPE APPROX. 75 FEET WEST OF ROAD

*DECLINATION 14 1/2 E  
 3 1/4" B.C. PROT 4 INCHES*

*BEARING IN ERROR, SHOULD BE N42 1/2 E TAG CORRECTED*

5) THE QUARTER CORNER BETWEEN SECTIONS 8 AND 17 GCDB 240500  
 FOUND 1959 BLM BRASS CAP 0.4 FEET ABOVE GROUND  
 - 20" DOUGLAS FIR BEARS S41 1/4°E 22.11 FEET (RECORD S41°E 22.44 FEET) HEALED FACE AND BLM TAG  
 - 28" DOUGLAS FIR BEARS N57°W 10.3 FEET (RECORD N53 1/2°W 11.22 FEET) HEALED FACE AND BLM TAG  
 CORNER LIES ON STEEP SOUTH FACING SLOPE APPROX. 100 FEET SOUTH OF OLD ROADWAY

*OCRS CANYONVILLE COTTAGE GROVE LODGE*

6) THE CENTER SOUTH 1/16 TH CORNER FOR SECTION 8 GCDB 240520  
 FOUND 1" IRON PIPE 0.2 FEET ABOVE GROUND PER SURVEY CS 51/86  
 - ROTTEN FIR STUMP BEARS N10 1/4°W 19.6 FEET (RECORD N10°W 19.8 FEET) VISIBLE SCRIBING  
 - ROTTEN FIR STUMP BEARS S79 1/4°W 5.9 FEET (RECORD S70°W 5.28 FEET) VISIBLE SCRIBING  
 - 9" DOUGLAS FIR BEARS N23 3/4°W 11.8 FEET WE SCRIBE CS 1/16 S8 BT AND TAGGED TREE  
 - 15" DOUGLAS FIR BEARS N49°E 23.5 FEET WE SCRIBE CS 1/16 S8 BT AND TAGGED TREE  
 CORNER LIES ON STEEP WEST FACING SLOPE

*175108.013 N  
 264336.992 E*

7) THE SOUTHEAST 1/16 TH CORNER FOR SECTION 8 GCDB 260520  
 FOUND 1" IRON PIPE 0.6 FEET ABOVE GROUND PER SURVEY CS 51/86  
 - 26" DOUGLAS FIR BEARS N5 1/4°W 27.5 FEET (RECORD N5°W 27.06 FEET) HEALED FACE AND TAG  
 - 8" DOUGLAS FIR BEARS N52 1/2°W 15.5 FEET WE SCRIBE SE 1/16 S8 BT AND TAG TREE  
 CORNER LIES ON WEST SIDE OF MAIN RIDGE.

8) THE CENTER WEST EAST SOUTHEAST 1/256 CORNER FOR SECTION 8  
 SET 5/8" X 40" IRON ROD WITH 2 1/2" ALUMINUM CAP MARKED LONE ROCK TIMBER S8 CW E SE 1/256 2016 PLS 2291  
 - 18" DOUGLAS FIR BEARS S23°W 16.2 FEET WE SCRIBE BT AND TAG TREE  
 - 17" DOUGLAS FIR BEARS N57 1/2°E 33.7 FEET WE SCRIBE BT AND TAG TREE  
 CORNER LIES ON SOUTHEAST SLOPE APPROX. 80 FEET S45°E FROM PROPOSED 2016 NEW ROAD CONSTRUCTION.  
 WE PUT METAL U - POST 0.5 FEET NORTH OF CORNER.

9) THE CENTER WEST EAST EAST 1/256 CORNER FOR SECTION 8  
 SET 5/8" X 40" IRON ROD WITH 2 1/2" ALUMINUM CAP MARKED LONE ROCK TIMBER S8 CW E E 1/256 2016 PLS 2291  
 - 13" DOUGLAS FIR BEARS N81 1/4°E 8.4 FEET WE SCRIBE BT AND TAG TREE  
 - 15" DOUGLAS FIR BEARS S1 1/4°E 28.3 FEET WE SCRIBE BT AND TAG TREE  
 CORNER IS 0.2 FEET ABOVE GROUND ON SOUTH FACING SLOPE. WE PUT METAL U - POST APPROX. 0.5 FEET NORTH OF CORNER.

10) THE CENTER EAST 1/16 TH CORNER FOR SECTION 8 GCDB 260540  
 SET 5/8" X 40" IRON ROD WITH 2 1/2" ALUMINUM CAP MARKED LONE ROCK TIMBER CE 1/16 S8 2016 PLS 2291  
 - 14" DOUGLAS FIR BEARS N8 1/4°E 9.3 FEET WE SCRIBE CE 1/16 S8 BT AND TAG TREE  
 - 12" DOUGLAS FIR BEARS S11 1/2°W 39.0 FEET WE SCRIBE CE 1/16 S8 BT AND TAG TREE  
 FOUND RAMSEY BEARING TREE STUMPS WITH IRON PIPE PUSHED OUT OF POSITION. WE RESET CORNER AT PROPORTIONATE DISTANCE. CORNER LIES AT NORTH EDGE OF THREE WAY ROAD JUNCTION. WE SET CORNER 0.1 FEET BELOW THE ROAD SURFACE AND PUT A METAL U - POST APPROX. 5.0 FEET NORTH OF CORNER.

11) THE CENTER QUARTER CORNER FOR SECTION 8 GCDB 240540  
 FOUND 1 1/2" IRON PIPE PER SURVEY CS 51/86  
 - 62" FIR STUMP BEARS N89 1/2°E 19.3 FEET (RECORD S88 °E 17.6 FEET) WEYCO TAG  
 - 30" FIR STUMP BEARS N61 1/2°E 24.1 FEET WEYCO TAG AND MAG NAIL TAG READS S60 1/2°W 26.3 FEET NO RECORD  
 - 12" DOUGLAS FIR BEARS N28 3/4°E 27.7 FEET WE SCRIBE C1/4 S8 BT AND TAG TREE  
 - 6" DOUGLAS FIR BEARS N80°W 13.7 FEET WE SCRIBE C1/4 S8 BT AND TAG TREE  
 - 13" DOUGLAS FIR BEARS N89 1/2°E 19.3 FEET WE SCRIBE C1/4 S8 BT AND TAG TREE  
 - 11" DOUGLAS FIR BEARS S31 1/4°W 34.4 FEET WE SCRIBE C1/4 S8 BT AND TAG TREE  
 CORNER LIES APPROX. 65 FEET WEST OF UNMAINTAINED ROCK ROAD

LEGEND


- FOUND 1959 BLM BCIP'S & 1918 US GLO BCIP
- FOUND IRON PIPES SET BY RAMSEY IN CS 51/86
- SET 5/8" X 40" IRON ROD WITH 2 1/2" ALUMINUM CAP
- [ ] RECORD FROM 1960 BLM PLAT 245

REGISTERED PROFESSIONAL LAND SURVEYOR

*Ken W. Hoffman*

*CS 67/56-58*

*3/4*

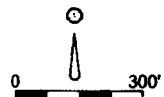

## County Surveyor's Record, Douglas County, Oregon

## Dependent Resurvey of a Portion of the Subdivisional Lines, T. 26 S., R. 2 W.

CHAINS 0.92	Skid road, 15 lks. wide, bears N. and S.
12.60	Dirt access road, 20 lks. wide, bears NE. and SW.
14.50	Top of ascent, slopes S.; desc. 114 ft. over SW. slope.
18.70	Dirt access road, 25 lks. wide, bears NW. curving to W. and SE. curving to E.
20.10	Point for the E 1/16 sec. cor. of secs. 8 and 17.  Set an iron post, 28 ins. long, $2\frac{1}{2}$ ins. diam., 24 ins. in the ground, and in a mound of stone, $2\frac{1}{2}$ ft. base, to top, with brass cap mkd.  <div style="text-align: center;"> <math display="block">\begin{array}{r} \text{E } 1/16 \end{array} \frac{\text{S } 8}{\text{S } 17}</math>           1959         </div> from which  A fir, 33 ins. diam., bears N. $84\frac{1}{2}^\circ$ E., 76 lks. dist., mkd. E 1/16 S8 BT.  A fir, 38 ins. diam., bears S. $51\frac{1}{2}^\circ$ E., 132 lks. dist., mkd. E 1/16 S17 BT.  Descend 266 ft. over SW. slope, through partially logged area.
30.70	Gravelled access road, 25 lks. wide, bears NW. curving to NE. and SE. curving to S.
34.43	Three-wire transmission line, bears NW. and SE.; also skid road, 15 lks. wide, bears NW. and SE.
35.92	Leave partially logged area, enter heavy timber, edge bears NW. and SE.
40.20	Point for the $\frac{1}{4}$ sec. cor. of secs. 8 and 17, at proportionate distance; there is no remaining evidence of the original corner.  Set an iron post, 28 ins. long, $2\frac{1}{2}$ ins. diam., 24 ins. in the ground, and in a mound of stone, 2 ft. base, to top, with brass cap mkd.  <div style="text-align: center;"> <math display="block">\begin{array}{r} \text{T } 26 \text{ S } \text{R } 2 \text{ W} \\ \frac{1}{4} \frac{\text{S } 8}{\text{S } 17} \\ 1959 \end{array}</math> </div> from which  A fir, 20 ins. diam., bears N. $53\frac{1}{2}^\circ$ W., 17 lks. dist., mkd. $\frac{1}{4}$ S8 BT.  A fir, 15 ins. diam., bears S. $41^\circ$ E., 34 lks. dist., mkd. $\frac{1}{4}$ S17 BT.  Descend 87 ft. over SW. slope.
43.83	Creek, 1 lk. wide, course SW.; desc. 299 ft. over SW. slope.
56.58	North Umpqua Highway, bituminous pavement, 40 lks. wide, bears S. and N. curving to NW.
57.85	Right bank of North Umpqua River, course NW.
61.45	Left bank of North Umpqua River; asc. 297 ft. over NE. slope.

CS 67/56-58 4/4