

GOVERNMENT CORNER RESTORATION FORM

TOWNSHIP 21S RANGE 9W SEC. 24

PLSS # 5002W

FILED
Date: 9/11/2023 By: X
This survey consists of:

DOUGLAS COUNTY OREGON

DATE 8/28/23

Map: _____
Narrative: _____
Corner Rpt: CS 67/56-61

Corner Designation

See. Cor 27/26
34/35

DOUGLAS COUNTY
SURVEYOR

Monument(s) Found: (Condition and Source)

BLM BRASS CAP BURIED
IN EAST TIRE TRACK OF
ROAD Not dug up

- Condition report
- Not Found
- Renewed
- Unrecorded
- Surveyed In

Previous Renewals

Roberts 1981 M 89-74
EDWARDS 2000 M 135-6
BLM Resurvey 2013 Vol
58 pg 23162-3

MONUMENT DETAIL

Accessories Found

Roberts BT'S
19" D Fir 7' high stump N 62° E 32.9 FT
Healed BLAZE
20" X 6 FT D. FIR STUMP S 45 1/2° E 39.4 FT
Healed BLAZE
27" X 15 FT D. FIR N 44° W 33.6 FT Healed
BLAZE
Reference monuments by BLM
5/8" X 30" Iron Rod with Alum. Cap N 20° 33' 02" E
30.3 FT STAMPED T21S R9W 30.3 FT TO COR S26
2013 ARROW pointing TO CORNER
5/8" X 30" Iron Rod with Alum Cap S 45° 45' 04" E
32.56 FT STAMPED RM T. 21S R9W 32.6 FT TO
COR S35 2013 AND A ARROW pointing TO
CORNER
5/8" X 30" Iron Rod S 49° 13' 41" W 30.18 FT
Under Fallen Log Not Looked For

C.S. File 67/56-61

Monument Set (Procedure and Description)

MONUMENT DETAIL

New Accessories


Sketch of Monument, Accessories, and General Area

Location & Comments

OCRS COORDINATE SYSTEM
 Cottage Grove Canyonville
 Zone

N 318877.721
 E 55182.912

Comp. Decline. 14 1/2° E
 Agency DCSO
 Party Chief S. F. WUSE
 Note keeper _____
 Witnesses J. LORSUNG

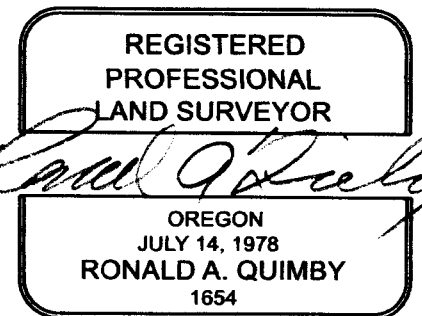

EXPIRES: 12/31/2024

CS 67/56 61 2/3

FND. OK 8/28/23

TOWNSHIP 21 RANGE 09 POINT IDENTIFIER # 500200

PRIMARY CORNER DESCRIPTION Cor. Secs. 26, 27, 34, & 35

Alias _____ Description OCCS CANYONVILLE COTTAGE GROVE COORD.S
 Alias _____ Description _____
 Alias _____ Description 318877.721 N
 Alias _____ Description 55182.912 E

from which the remains of the original bearing trees
 A decayed fir stump, size indeterminate, bears S.20°E., 52.1 ft., no marks visible.
 A very decayed hemlock stump, size indeterminate, bears S.59°W., 31.0 ft., no marks visible.
 and the remains of the bearing trees mkd. by Roberts ✓
 A ✓ fir stump, 7 ✓ ft. high, ✓ 19" dia., bears N.62°E., 32.9 ft., with a healed blaze.
 A ✓ fir stump, 6 ft. ✓ high, ✓ 20" dia., bears S.45½°E., ✓ 39.4 ft., with a healed blaze.
 A root hole bears S.72½°W., 33.8 ft., alongside of which is an uprooted fir, 28" dia., with a healed blaze.
 NOW 27" x 15 FT. A ✓ fir, 26" dia., bears N.44°W. ✓ 33.6 ft., with a healed blaze.

At the corner point
 Set a stainless steel post, 28" long, 2½" dia., 40" in the ground, with a brass cap mkd.

T 21 S R 9 W
 S 27 | S 26
 S 34 | S 35
 2013

BURIED DEEP NOT UNCOVERED
 EAST EDGE OF GRAVEL RD.
 EAST TIRE TRACK

and new reference monuments
 An iron rod, 30" long, 5/8" dia., set 30" in the ground, ✓ bears N.20°33'02" E, 30.30 ft., with aluminum cap mkd. RM T21S R9W 30.3 FT TO COR S26 2013, and an arrow pointing to the cor.
 ✓ An iron rod, 30" long, 5/8" dia., set 30" in the ground, bears S.45°45'04" E, 32.56 ft., with aluminum cap mkd. RM T21S R9W 32.6 FT TO COR S35 2013, and an arrow pointing to the cor. FALLEN LOG AT LOC. NOT LOOKED FOR
 An iron rod, 30" long, 5/8" dia., set 30" in the ground, bears S.49°13'41" W, 30.18 ft., with aluminum cap mkd. RM T21S R9W 30.2 FT TO COR S34 2013, and an arrow pointing to the cor.
 Remove steel pin from the area.
 Corner is located in a gravel road, 5 ft. East of the center, 12 ft. wide, bears N. 10° W and South, in curve.

DECLINATION 14½°E

CS 67/56-61
3/3