

GOVERNMENT CORNER RESTORATION FORM

FILED

TOWNSHIP 24S RANGE 2W SEC. 31

PLSS # 200100

Date: 9/11/2023 By: JC
This survey consists of:

DOUGLAS COUNTY OREGON

DATE 9-6-23

Map: _____

Narrative: _____

Corner Rpt: CS 67/56-64

Corner Designation

See Cor S31/S32
S6/S5

DOUGLAS COUNTY
SURVEYOR

Monument(s) Found: (Condition and Source)

BLM 2 1/2" BRASS CAP IN
MOUND OF STONE UP 5"

Condition report

Not Found

Renewed

Unrecorded

Surveyed In

Previous Renewals

BLM Resurvey 1951-1963 Vol 32

pgs 13282-83

SHANKER 1964 CS 51/281-2 added 2018 T24S R2W

EDWARDS 2013 CS 65/78-12

BLM Resurvey 2014-2015 Vol

58 pgs 23330-1

MONUMENT DETAIL

S31/S32

S6/S5

T255

1951

Accessories Found

ORIG. BT'S

BURNED 48' X 2 1/2 FT Decayed FIR STUMP

N25°E 33.1 FT

36' X 3 FT FIR STUMP S55 3/4 W 13.2 FT

BT'S BY Tallett & White

Burnt. DEAD 18" Hemlock S68°E 60.1 FT

Healed BLAZE Add 3 1/2" Mag Nail RIGHT Sid Center

Burnt - SAWN 28' X 2 FT Hemlock STUMP N12 1/4 W

56.1 FT Healed BLAZE Add 3 1/2" Mag Nail Top Center

BT'S BY EDWARDS

BURNED - DEAD 13" Hemlock S21°W 31.3 FT

(Rec S22 3/4 W) BURNED out BLAZE ADD 3 1/2"

MAG NAIL RIGHT Side Center

C.S. File 67/56-64

Monument Set (Procedure and Description)

MONUMENT DETAIL

New Accessories

BURNED- DEAD 21" Hemlock S23°E 17.8 FT
3 1/2" MAG Nail RIGHT SIDE CENTER

BURNED- DEAD 12" Hemlock S19°W 23.0 FT
3 1/2" MAG Nail RIGHT SIDE CENTER

Note: Trees Not BLAZED or Scribed

Sketch of Monument, Accessories, and General Area

Location & Comments


OCRS COORDINATE SYSTEM
Cottage Grove - Canyonville Zone

AREA BURNED

9/2020

N 218250.752
E 240567.307

Comp. Decline. 14 1/2° E
Agency DCSU
Party Chief S. F. HAUSE
Note keeper
Witnesses J. LORSUNG

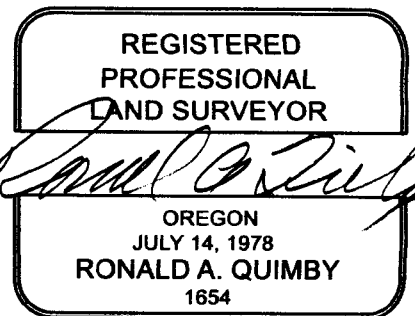

EXPIRES: 12/31/2024

CS 67/56-64 215

PRIMARY CORNER DESCRIPTION Sec. Cor. for 31 & 32; 5 & 6, T25-2

Alias _____	Description _____
Alias _____	Description _____
Alias _____	Description _____
Alias _____	Description _____

Set an iron post 36" long, 2" dia., 20" in the ground to solid rock and in a mound of stone, 4 ft. base, to top, with brass cap mkd.

T 24 S	R 2 W
S 31	S 32
S 6	S 5
T 25 S	
1951	

from which new bearing trees:

- A Hemlock 9" dia., bears S.68°E., 91 lks. dist., mkd. T25S R2W S5 BT. (1963 BT)
- A Yew 7" dia., bears S.86½°W., 40 lks. dist. mkd. T25S R2W S6 BT. (1963 BT)
- A Hemlock 16" dia., bears N.12¼°W., 85 lks. dist., mkd. T24S R2W S31 BT. (1951 BT)

Fd BC & 7 BTs B Shaner, 6/1964 CS 51/281-2 (added 10/16/2018)

David Edwards - March 2013 - C.S. File 65/78-12

Found - 1951 BLM brass cap in mound of stones.
 The original bearing trees are all stumps.
 The 1951 Yew BT is down.
 A 19" dia. Hemlock with healed blaze bears S.68°E., 60.1 ft.
 A 27" dia. Hemlock with healed blaze bears N.12¼°W., 56.1 ft.
 Both are 1951 BLM bearing trees.

New - An 8" dia. Fir scribed "T24S R2W S32 BT" bears N.72°E., 35.8 ft.
 A 9" dia. Fir scribed "T25S R2W S6 BT" bears S.22°N., 32.0 ft.
 A 6 foot steel post is set 2.5 ft N.85°E.

Note - Decl. 18 East.

BLM Dependent resurvey by Richard J. Dieckmann, Cadastral Surveyor, under Group No. 2749 , surveyed Aug. 2014/April 2015 - (DCSO records Vol. 58 Page(s) 23330-1)

The cor. of secs. 5, 6, 31, & 32, on the N. bdy. of the Tp., perpetuated by Edwards, in 2013, monumented with an iron post, 2" dia., firmly set, projecting 5" above the ground, in a collar of stone, with a brass cap (properly) mkd. 2 1/2" B.C. from which the remains of the original bearing trees

NOW BURNED A decayed fir stump, 48" dia., bears N.25°E., 33.0 ft., with fragmentary scribe marks visible on a partially healed, decayed blaze.

GONE NO EVID. A decayed hemlock stump, size indeterminate, bears N.85°E., 46.2 ft., with no marks visible. cont.

TOWNSHIP 24 RANGE 02 POINT IDENTIFIER # 200100

PRIMARY CORNER DESCRIPTION Sec. Cor. for 31 & 32; 5 & 6, T25-2

Alias _____	Description <u>OCRS CANYONVILLE COTTAGE GROVE COMM.S</u>
Alias _____	Description _____
Alias _____	Description <u>218250.752 N</u>
Alias _____	Description <u>260567.307 E</u>

SEE PAGE 2 FOR MONUMENT AND 2 ACCS.

36" x 3 FT A fir stump, 52" dia., bears S.55¹/₄°W., 13.2 ft., with no marks visible.

BURNED DEAD

and bearing trees mkd. by Tallett and White in 1951-63
A hemlock 18" dia., bears S.68°E., 60.1 ft., with a healed blaze.

BURNED SAWN 28" x 2 FT STUMP

A hemlock, 27" dia., bears N.12¹/₄°W., 56.1 ft., with a healed blaze.

GONE NO EVID.

and bearing trees mkd. by Edwards
A D Fir, 10" dia., bears N.71°E., 36.3 ft., with scribe marks T24S R2W S32 visible on a partially healed upper blaze and BT visible in lower blaze.

BURNED DEAD 13" HEMLOCK

A D Fir, 11" dia., bears S.22¹/₈°W., 31.3 ft., with scribe marks ~~T25S R2W S6~~ visible on a partially healed upper blaze and BT visible in lower blaze. **BURNED OUT BLAZE**

From this cor., a point established by person(s) unknown, monumented with an iron pipe, 2" dia., firmly set, projecting 4" above the ground, bears N.22°56'49"W, 4.00 ft., and is not utilized in the course of this survey

NEW REF.

BURNED DEAD 21" HEMLOCK 3 1/2" MAGNAIL RSC BEARS S 23° E, 17 8

BURNED DEAD 12" HEMLOCK " " " " " S 14° W, 23 0

PRIMARY CORNER DESCRIPTION Sec Cor. for 31 & 32; 5 & 6, T25-2

Alias _____	Description _____
Alias _____	Description _____
Alias _____	Description _____
Alias _____	Description _____

GLO survey by John A. McQuinn, Deputy Surveyor, under Contract #466, dated April 5, 1883 (DCSO records Vol. 7 Page(s) 2871-72)

-
- Set Cedar post 4" sq., 4 ft. long, 24" in the ground for cor. to secs. 5, 6, 31 and 32, mkd. T24S S32 on NE.; R2W S5 on SE.; T25S S6 on SW.; S31 on NW. faces, with 1 notch on W. and 5 notches on E. edges, from which
- A Fir 48" dia., bears N.20°E., 50 lks. dist. mkd. T24S R2W S32 BT.
 - A Hemlock 18" dia., bears S.85°E., 78 lks. dist. mkd. T25S R2W S5 BT.
 - A Fir 40" dia., bears S.50°W., 20 lks. dist. mkd. T25S R2W S6 BT.
 - A Hemlock 10" dia., bears N.60°W., 50 lks. dist. mkd. T24S R2W S31 BT.

BLM resurvey by Levi E. Tallett and C. Albert White, Cadastral Surveyors, under Group #294, Surveyed May 1951/Aug. 1963 - (DCSO records Vol. 32 Page(s) 13282-83)

"The intermediate corners along this line which were established by McQuinn formerly referred only to T. 24 S., R. 2 W. The purported retracement of the south boundary of sec. 31 and the reported establishment of closing corners on the boundary by Hezekiah Johnson in 1900 **having proved to be fictitious**, the McQuinn corners except for the south ¼ sec. cor. of sec.31 and the south ¼ sec. cor. of sec. 36, are changed in 1963 to corners of maximum control in order to provide a basis for Consent Decree "Civil No. 60-135, Oregon." (Hezekiah Johnson fictitious corner on Page 3656)

The cor. of secs. 31 and 32, determined from the original bearing trees:

- A Fir 50" dia., bears N.25°E., 50 lks. dist., with partial scribe marks on old bark blaze. (In 1951) (Rec. brg. N.20°E.) In 1963, this is a sawed Fir stump with no marks remaining.
- A Hemlock 20" dia., bears N.85°E., 70 lks. dist., mkd. T25 R2 S5 BT. (Rec. S.85°E., 78 lks. dist.)
- A Fir 50" dia., bears S.55°45'W., 20 lks. dist., with partial scribe marks on old bark blaze. (Rec. brg. S.50°W.)
- A broken Hemlock 14" dia., bears N.56°W., 50 lks. dist. mkd. T24 R2 S31 BT. (Rec. brg. N.60°W.)

At the corner point
(Cont. Next Page)

43° 25' 53"
122° 58' 11"