

GOVERNMENT CORNER RESTORATION FORM

FILED

TOWNSHIP 30S RANGE 5W SEC. 11 PLSS # 540500

Date: 10/17/2023 By: X  
This survey consists of:

DOUGLAS COUNTY OREGON

DATE 10-16-23

Map: \_\_\_\_\_  
Narrative: \_\_\_\_\_  
Corner Rpt: CS 67/57-2

Corner Designation

DOUGLAS COUNTY  
SURVEYOR

$\frac{1}{4}$   $\frac{S11}{S14}$

Monument(s) Found: (Condition and Source)

Condition report

NO monument Fd

Not Found

Renewed

Unrecorded

Surveyed In

Previous Renewals

MARKHAM 1958 CS 42/349

DCSO 1963 CS 53/26-9

BLM Resurvey 1967-1969 Vol  
38 pgs 15527-28

DCSO 1980 CS 61/6-36

BLM Resurvey 1999 Vol 53 pg 20511

DCSO-G15 2004 CS 67/33-1

MONUMENT DETAIL

Accessories Found

MARKHAM TBT'S (1999 BLM Rec Bearing & distances)

14" OAK N 8 1/4° E 69.3 FT HEADED BLAZE

9" OAK N 26 1/2° E 61.7 HEADED BLAZE

36" MADRONE N 48 1/4° W 71.9 FT NO MARKS  
VISIBILE

C.S. File 67/57-2  
1/2

RENEWAL

Monument Set (Procedure and Description)

2 1/2" O.D. ALUMI PIPE 30" LONG  
WITH 3 1/4" ALUMI CAP. 3"  
BELOW THE SURFACE OF ATV  
TRAIL. A 5/8" IRON ROD  
SET INSIDE OF MONUMENT  
SET @ INTERSECTION OF B TO DIST.

MONUMENT DETAIL

Douglas County  
T309 R5W  
1/4 E11  
1/4 1  
S14  
2023


New Accessories

Surveyors Office

Sketch of Monument, Accessories, and General Area

Location & Comments

Comp. Decline. 14 1/2° E  
Agency DCSO  
Party Chief S. Fause  
Note keeper  
Witnesses J. Loring

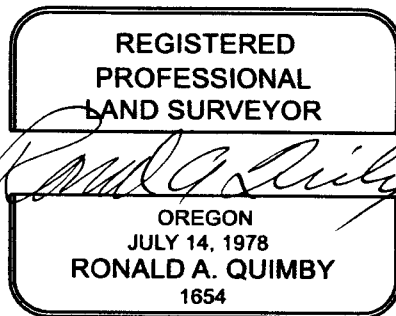

EXPIRES: 12/31/2024

CS 67/57-2  
212

Edward's

IDENTIFIER # 540500

Secs 11 and 14

David's crew had set a nail  
at the corner position. We verified  
bearing + distances. We set an  
aluminum pipe w/ aluminum cap  
30" LONG w/ 3 1/4" Diameter Cap  
Marked

act #44 dated May 30,  
m which  
lks.  
lks.

: DOUGLAS COUNTY

T 30S R 5W

1/4 S11  
+

S14

2023

SURVEYOR'S OFFICE

umber Co. - Witnesses:  
- March 20-25, 1958 -

ch  
. 1/4 S11 BT.  
d. 1/4 S11 BT.  
nkd. 1/4 S11 T30S BT.

est, 2525.0 ft.

Byron, Deputy - Mike

SET 3" BELOW THE SURFACE  
OF ATV TRAIL 5/8 IRON ROD  
INSIDE MONUMENT.

l BTs as recorded by  
ch bears N.7°E., 69.0

d: County Surveyor's  
Office, 1963

Resurvey by Roseberry  
Oct. 1967/June 1969  
No new suitable tree

Doug. County Surveyors Office - Stephen J. Flause - Terrie  
Plouff; Shawn Means - April 28, 1980 - C.S. File 61/6-36

Found - A 6" now a 13" B.Oak bears N.7°E., 69.3 ft. (Rec.  
N.7°W., 69.0 ft. corrected by Byron in 1963 to  
N.7°E., 69.0 ft. recorded in BLM survey as  
N.8 1/4°E., 69.3 ft.) with healed double blaze, no  
scribing visible.

A 5" now a 9" W.Oak bears N.26°E., 61.8 ft. has  
healed double blaze, no scribing visible.

(Cont. Next Page)

CS 67/52-2  
3/4

TOWNSHIP 30 RANGE 05 POINT IDENTIFIER # 540500

PRIMARY CORNER DESCRIPTION 1/4 Cor. for Secs. 11 and 14

Alias _____	Description _____
Alias _____	Description _____
Alias _____	Description _____
Alias _____	Description _____

24" now a 31" Madrone bears N.51°W., 72.5 ft. (Rec. 75.0 ft., which appears to be a slope measurement) (BLM record N.51 3/4°W., 71.9 ft.) Tree has healed double blaze, no scribing visible.

Set a 1" x 30" Iron pipe with brass cap properly stamped and protruding 0.1 ft. from surface.

This corner was set previously by BLM resurvey in 1969. (I did not find a "set" corner by BLM in 1969. V.L. 6/29/93) No monument was found, appears to have been removed as we find a depression in soil marked with stake and flagging. Corner was renewed from checking bearings and distances from stake found in depression. No other trees available, existing trees are retagged as recorded.

BLM Dependent resurvey by Timothy J. Moore, Cadastral Surveyor and Robert H. Browning, Surveying Technician, under Group #1906, surveyed June/Aug. 1999. (DCSO rec. Vol. 53 page(s) 20511)

-----

Beginning at the 1/4 sec. cor. of secs. 11 & 14, remonumented in 1980 by the Douglas County Surveyors Office, monumented with an iron pipe, 1 1/4" diam., firmly set, projecting 4" above ground, with brass cap mkd. COUNTY SURVEYORS OFFICE

T 30 S  
 1/4 S 11  
 S 14  
 R 5 W  
 1980

from which bearing trees mkd. by Markham, Deputy County Surveyor, in 1958

- ✓ An oak, 14" dia., bears N.8 1/4°E., 69.3 ft., with a healed blaze.
- ✓ An oak, 9" dia., bears N.26 1/2°E., 61.7 ft., with a healed blaze. (Record, N.27 1/4°E.)
- ✓ A madrone, 36" dia., bears N.48 1/4°W., 71.9 ft., with no marks visible. (Record, N.51 3/4°W.)

No new suitable trees within limits in sec. 14.  
 Corner is located on the North edge of an open grassy field, and South, 59.0 ft. of a woven wire fence with 1 strand of barbed wire attached, extending East and West.

DCSO-GIS Corner visitation - 3/9/2004 - Typed: 2/8/2011 - C.S. File 67/33-1

-----

Monument - 1 1/4" IP/BC                      Comment - OK

CS 67/33-1  
 4/4                      2