

GOVERNMENT CORNER RESTORATION FORM

FILED

TOWNSHIP 24S RANGE 2W SEC. 28

PLSS # 300240

Date: 10/30/2023 By: X
This survey consists of:

DOUGLAS COUNTY OREGON

DATE 10-17-23

Map: _____

Narrative: _____

Corner Rpt: CS 67/57-4

Corner Designation

1/4 COR 29/28

DOUGLAS COUNTY
SURVEYOR

Monument(s) Found: (Condition and Source)

2 1/2" BRASS CAP 4 P 5"

___ Condition report

___ Not Found

___ Renewed

___ Unrecorded

___ Surveyed In

Previous Renewals

BLM Resurvey 1951-1963
Vol 32 pg 13301

MONUMENT DETAIL

L. Wilson & R. Rice 1977 Filed
CS 58/8-23 1980

1/4
S29 / S28
1951

Accessories Found

SAWN BURNT. SHATTERED 20" X 1 1/2 FT Hemlock
Stump N 46° E 10.7 FT (Rec N 44 1/2° E
Drove 5/8" X 36" Iron Rod with DCSD
PLASTIC CAP IN TOP CENTER CAP UP 2"
NO FACE REMAINS

BURNED MOSTLY ROTTED AWAY 24" X 2 FT FIR
Stump N 53 1/2° W 21.1 FT

C.S. File 67/57-4

RENEWAL

Monument Set (Procedure and Description)

MONUMENT DETAIL

New Accessories

SAW 14" X 1 1/2 FT FIRE STUMP N 43° E
37.0 FT 3 1/2" MAG Nail Top Center

5/8" X 30" Iron Rod with DCSD plastic cap
up 4" S 7 1/2° W 10.5 FT

5/8" X 30" Iron Rod with DCSD PLASTIC CAP
up 4" West 7.6 FT

Sketch of Monument, Accessories, and General Area

Location & Comments


ON Flat Ridge Top Approx
450 FT ± N 40° W FROM TOP
OF ROCK Pt + West Edge ROAD

OCRS COORDINATE SYSTEM
COTTAGE GROVE CANYONVILLE ZONE

N 225183.112
E 266628.128

AREA BURNED
9/2020

Comp. Decline. 14 1/2° E
Agency DCSD
Party Chief S. Flouse
Note keeper
Witnesses J. Lorusso

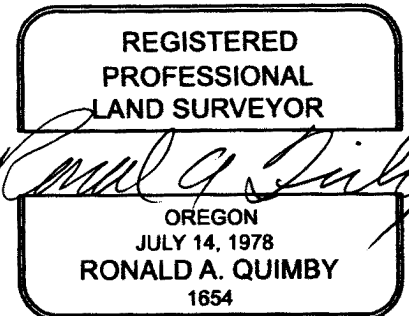

EXPIRES: 12/31/2024

CS 67157.4

TOWNSHIP 24 RANGE 02 POINT IDENTIFIER # 300240

PRIMARY CORNER DESCRIPTION 1/4 Cor. Secs. 28 & 29

Alias _____	Description <u>CCRS CANYONVILLE COTTAGE GROVE COORD.S</u>
Alias _____	Description _____
Alias _____	Description <u>225183.112 N</u>
Alias _____	Description <u>266628.128 E</u>

GLO survey by John. A. McQuinn, Deputy Surveyor, under Contract #466 dated April 1883 - (DCSO recs Vol. 7 Page 2887)

Set post, 3 ft. long, & 3" sq., 24" in the ground for the 1/4 sec. cor. marked 1/4 S on W face, from which:

A hemlock, 24" dia., bears N.40°E., 16 lks., mkd: 1/4 S BT.
 A fir, 18" dia., bears N.50°W., 32 lks., mkd: 1/4 S BT.

BLM dependent resurvey Levi E Tallett, Cadastral Engineer (1951) and C. Albert White, Cadastral Surveyor (1963), under Group # 294, surveyed May 1951 - Aug 1963 - (DCSO records Vol. 32 Page(s) 13301)

The 1/4 sec. cor. of secs. 28 & 29 determined at the record bearing & distance from the orig. BTs:

A hemlock, 36" dia., bears N.40°E., 16 lks., blaze partially healed, scribe marks 1/4 S visible.
 A fir, 30" dia., bears N.53 1/2°W., 32 lks., blaze healed, lower blaze cut open, shows the scribe marks BT under 68 years of overgrowth. (Rec. bearing N.50°W.)

At the corner point
 Set an iron post, 36" long, 1" dia., 28" in the ground, with brass cap marked:

1/4
 S 29 | S 28
 1951

No new accessories established.

L. Wilson & R. Rice - For: Weyerhaeuser Co. - 4/18/1977 (Filed 12/1980) - C.S. File 58/8-23

Found - No trace of 1883 cedar post.

Orig. 24" now 38" Hemlock, scribing visible, bears N.44 1/2°E., 10.7 ft., from 1951 GLO brass cap to center of BT. - DRIVE 5/8" x 30" I.R./DCSO IN TOP CENTER STUMP
 NO FACE REMAINING

Orig. 18" now 32" Fir, scribing visible, bears N.53 1/2°W., 21.1 ft., from 1951 GLO brass cap to center of BT.

1951 brass cap in place. 2 1/2" BC MON. AS DESCRBD PROT. 5"
 New - Drove 2" fir post alongside brass cap.
 Added "W" nails & Weyerhaeuser plates to BTs - NOT FOUND

DECLINATION 14 1/2° E

NEW REKS

SAWN STUMP 14" x 1 1/2 FT FIR - 3 1/2" MON NAIL TOP CONTR. N 43° E, 37° FT
 5/8" x 30" I.R./DCSO SET PROTRUDING 4" ABV. GRND ST 1/2 W, 105 FT.
 PLSTC CAP
 " " " " " WEST, 76 FT.

MONUMENT ON FLAT RIDGE TOP APPROX. 450 FT. N 40° W FROM TOP OF ROCK PIT WEST EDGE RD.

WEST 1105 ROCK PIT 43-115049, 122-94699

SAWN BURNED SHATTERED 20" x 1 1/2 FT. STUMP
 BURNED MOSTLY ROTTED AWAY FIR STUMP 24" x 2 FT