

GOVERNMENT CORNER RESTORATION FORM

FILED

TOWNSHIP 24S RANGE 2W SEC. 26

PLSS # 540206 Date: 10/30/2023 By: JC

This survey consists of:

DOUGLAS COUNTY OREGON

DATE 10-18-23

Map: \_\_\_\_\_

Narrative: \_\_\_\_\_

Corner Rpt: CS67/57-5

Corner Designation

DOUGLAS COUNTY SURVEYOR

1/4 COR 26/35

Monument(s) Found: (Condition and Source)

\_\_\_ Condition report

BLM BRASS CAP

\_\_\_ Not Found

UP 6"

\_\_\_ Renewed

Previous Renewals

\_\_\_ Unrecorded

\_\_\_ Surveyed In

BLM Resurvey 1951-1963

Vol 32 pg 13294

DC30 1969 CS 54/27-242

Smalley 2009 CS 65/66-43

Quimby 2020 CS 65/106-51

MONUMENT DETAIL

1/4 526  
535  
1951

Accessories Found

Root hole N42°E 67.2 FT

BURNED BROKEN OFF 45" X 20 FT FIR SNAG

S14 1/2°E 44.7 FT

10" Hemlock N52°E 6.4 FT NAIL IN

Side Center

SAWED 8" X 2 1/2 FT FIR STUMP N11°E 15.2 FT

(Rec N6°E 15.0) ADD 3 1/2" MAG NAIL TOP CENTER

10" D. FIR N26 1/2°W 9.6 FT (Rec N31°W)

Dist To Nail Side Center

Down 8" Hemlock S52°E 31.1 FT Dist

To Roots Vis Scribes ON PARTIALLY

HEATED SINGLE BLAZE

C.S. File 67/57-5

Monument Set (Procedure and Description)

MONUMENT DETAIL

New Accessories

5" Hemlock scribed "X" "BT" ON High  
LOW BLAZE BEARS S 40° W 3.6 FT

Sketch of Monument, Accessories, and General Area

Location & Comments


CCRS COORDINATE SYSTEM  
COTTAGE GROVE - CANYONVILLE  
ZONE

MAP. ON MODERATE  
NORTH SLOPE, OLD  
GROWTH FOREST TO  
SOUTH, CLEAR CUT  
TO NORTH

N 224724.376  
E 278548.007

AREA BURNED 9/2000  
Comp. Decline. 14 1/2° E  
Agency DCSD  
Party Chief S. F. AUSE  
Note keeper  
Witnesses J. LORSUNG

REGISTERED  
PROFESSIONAL  
LAND SURVEYOR

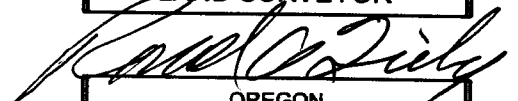

OREGON  
JULY 14, 1978  
RONALD A. QUIMBY  
1654

EXPIRES: 12/31/2024

CS 67/57-5  
2/4

TOWNSHIP 24 RANGE 02 POINT IDENTIFIER # 540200

PRIMARY CORNER DESCRIPTION 1/4 Cor. Secs. 26 & 35

Alias \_\_\_\_\_ Description \_\_\_\_\_  
Alias \_\_\_\_\_ Description \_\_\_\_\_  
Alias \_\_\_\_\_ Description \_\_\_\_\_  
Alias \_\_\_\_\_ Description \_\_\_\_\_

GLO Survey by Henry L. Chandler, U.S. Deputy Surveyor, under Contract #619 dated June 5, 1893 - (DCSO records Vol. 7 Page(s) 2903)

-----  
Set post, 3 ft. long, & 3" sq., 24" in the ground for the 1/4 sec. cor. marked 1/4 S on N face, from which:

A fir, 12" dia., bears N.52°E., 22 lks., mkd: 1/4 S BT.

A cedar, 8" dia., bears S.70°W., 36 lks., mkd: 1/4 S BT.

-----  
BLM dependent resurvey Levi E Tallett, Cadastral Engineer (1951) and C. Albert White, Cadastral Surveyor (1963), under Group # 294, surveyed May 1951 - Aug 1963 - (DCSO records Vol. 32 Page(s) 13294)

-----  
The 1/4 sec. cor. of secs. 26 & 35, determined from the remains of the orig. BTs.

A fallen fir, 18" dia., bears N.52°E., 22 lks., blazed healed, edge of face under 56 yrs. of overgrowth, down for approx. a year.

A fallen cedar, 18" dia., bears S.70°W., 36 lks., blaze healed.

At corner point

Set an iron post, 36" long, 1" dia., 28" in the ground, with brass cap marked:

1/4  $\frac{S\ 26}{S\ 35}$   
1951

from which

A fir, 26" dia., bears N.42°45'E., 102 lks., mkd: 1/4 S26 BT

A fir, 40" dia., bears S.14 1/2°E., 98 lks., mkd: 1/4 S35 BT.

-----  
Douglas Co. Surveyors Office - Vernon "Ray" Tracy - Jack Heritage - V. Perron - Aug. 20 1969 - C.S. File 54/27-242

-----  
Found - 1951 Cad. brass cap in place, properly mkd.  
26" now 27" fir, low cut stump, N.42 3/4°E., 67.3 ft., find scribe.

40" now 41" fir, alive, S.14 1/2°E., 64.7 ft., pitched blaze.

New BT - 9" Hemlock N.83°W., 24.1 ft., mkd: "1/4 S26 CS BT"

Note - This corner lies 5 ft. south of cat fir trail for recent logging in Sec. 26.

-----  
Mark Smalley, Roseburg Forest Products - Party Chief: William Olson - Witness Niel Danko - June 2009 - C.S. File 65/66-43

-----  
Found - 1951 Cad brass cap, properly marked. **PROT. 6"**  
~~27" fir, low cut stump, N.42°E.~~ (Rec. N.42°45'E), continued next page  
**BURNED AWAY** 67.3' 1951

**ROOT HOLE**

CS 67/57-5

3/4

TOWNSHIP 24 RANGE 02 POINT IDENTIFIER # 540200

PRIMARY CORNER DESCRIPTION 1/4 Cor. Secs. 26 & 35

Alias _____	Description <u>OKAS CANYONVILLE COTTAGE GROVE COORD. 5</u>
Alias _____	Description _____
Alias _____	Description <u>224724.376 N</u>
Alias _____	Description _____
Alias _____	Description <u>278548.007 E</u>

SEE PAGE 1 FOR MONUMENT DESCR.

BROKEN OFF BURNED  
45" x 20 FT. SNAG

47" fir, S. 14 1/2° E., 64.7' 25" tall snag, 1951  
5" Hemlock, N. 83° W., 24.1', gone 1969

New LIVE 10" 8" Hemlock, N. 52° E., 6.4' measured to nail in side center of stump, scribed "S1/4BT"

SAWN STUMP 8" x 2 1/2 FT.

8" D. Fir, N. 5° E. 11° 15.2' measured to nail in side center of stump, scribed "S1/4BT" ADD 3 1/2 MAG NAIL TOP CNTR.

LIVE 10" 7"

D. Fir, N. 51° W. 26 1/2° 9.6' measured to nail in side center of stump, scribed "S1/4BT"

SINGED DEAD FALLEN 8"

Hemlock, S. 52° E., 31' 1" measured to nail in side center of stump, scribed "S1/4BT" MEAS. TO ROOTS SCRIB VIS. ON PH 58

ERROR NOT STUMP

Fd Ok by R Quimby 10/2020 - C.S. File 65/106-51

DECLINATION 14 1/2° E

NEW REF

LIVE 5" HEMLOCK SCRIBED "X" "BT" ON HIGH LOW BLZ. BEARS 540° W, 36 FT.

MONUMENT ON MODERATE N NORTH SLOPE, OLD GROWTH FOREST SOUTH, CLEAR-CUT NORTH