

GOVERNMENT CORNER RESTORATION FORM

FILED

TOWNSHIP 24S RANGE 2W SEC. 21

PLSS # 340300

Date: 10/30/2023 By: X

This survey consists of:

Map: \_\_\_\_\_

Narrative: \_\_\_\_\_

Corner Rpt: 67/57-7

DOUGLAS COUNTY OREGON

DATE 10-23-23

DOUGLAS COUNTY SURVEYOR

Corner Designation

$\frac{1}{4}$  COR  $\frac{21}{28}$

Monument(s) Found: (Condition and Source)

2 1/2" DCSO BRASS CAP  
ON 1" I.D IRON PIPE  
UP 8"

Previous Renewals

DCSO 1969 CS 54/27-247

Condition report

Not Found

Renewed

Unrecorded

Surveyed In

MONUMENT DETAIL

DOUGLAS COUNTY  
SURVEYOR'S OFFICE  
24S R2W

$\frac{1}{4}$   $\frac{521}{528}$   
1969

Accessories Found

3/4" Iron Rod North 10.0 FT

3/4" Iron Rod West 20.0 FT

Fence Post Loose on Ground Reset  
1.0 FT South

C.S. File 67/57-7

Monument Set (Procedure and Description)

MONUMENT DETAIL

---



---



New Accessories

16" X 1 1/2 FT SAWN FIR STUMP S48°W  
7.6 FT 3 1/2" MAG NAIL TOP CENTER

18" X 1/2 FT SAWN FIR STUMP N42°W  
7.7 FT 3 1/2" MAG NAIL TOP CENTER

Sketch of Monument, Accessories, and General Area

Location & Comments


OCRS COORDINATE SYSTEM  
COTTAGE GROVE - CANYONVILLE  
ZONE

COR. 12 APPROX  
150 FT SOUTH OF  
GRAVEL ROAD

AREA BURNED  
9/2020

N 229 608.934  
E 268 308.686

Comp. Decline. 14 1/2° E  
Agency DCSD  
Party Chief S. F. MUSE  
Note keeper  
Witnesses J. LORSUNG

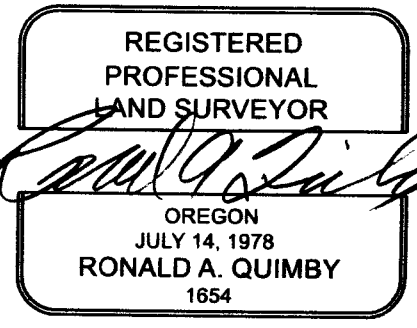

EXPIRES: 12/31/2024

CS 67/57-7

NOT ON LIST

RENEWED 10/23/23

TOWNSHIP 24 RANGE 02 POINT IDENTIFIER # 340300

PRIMARY CORNER DESCRIPTION 1/4 Cor. Secs. 21 & 28

Alias \_\_\_\_\_ Description DCRS CANYONVILLE COTTAGE GROVE CORNERS  
 Alias \_\_\_\_\_ Description \_\_\_\_\_  
 Alias \_\_\_\_\_ Description 229608.934 N  
 Alias \_\_\_\_\_ Description \_\_\_\_\_  
268308.686 E

GLO Survey by Henry L. Chandler, U.S. Deputy Surveyor, under Contract #619 dated June 5, 1893 - (DCSO records Vol. 7 Page(s) 2916)

-----  
 Set post, 3 ft. long, & 3" sq., 24" in the ground for the 1/4 sec. cor. marked 1/4 S on N face, from which:  
 A hemlock, 5" dia., bears N.60°E., 12 lks., mkd: 1/4 S BT.  
 A fir, 16" dia., bears S.20°E., 25 lks., mkd: 1/4 S BT.

Douglas Co. Surveyors Office - Vernon "Ray" Tracy - Jack Heritage - V. Perron - Aug 1969 - C.S. File 54/27-247

-----  
 Found - Orig. 16" now 18" fir decayed stump, S.20°E., 16.5 ft., open & find "1/4 S" scribe.

2 1/2" B.C. ON 1" I.D. I.P.

No trace of other orig. BT  
Weyerhaeuser reference trees now burned stumps.

Set - Brass cap at cor. mkd: County Surveyors T24S R2W  
 Office (1/4 S 21) PROT 8"  
 1969 ← (1/4 S 28)  
 (6' steel fence post set alongside BC)

FENCE POST FOUND LOOSE ON SURFACE RESET SOUTH 1 FT.

No trees nor solid stumps available, we set:  
3/4"x30" I.Rod, North 10.0 ft.

TOP FLUSH WITH GRND.

" " " " 3/4"x30" I.Rod, West 20.0 ft. as reference to 1/4 corner  
This corner lies in old clear cut unit in greasewood.

DECLINATION 14 1/2° E

NEW REFERENCES:

A 16" X 1 1/2 FT. SAWN FIR STUMP WITH A 3 1/2" MAG NAIL TOP CENTER S48°W, 76 FT.

A N 18" X 1/2 FT " " " " " " " " " " N42°W, 72 FT.

MONUMENT LIES APPROX. 150 FT SOUTH FROM GRAVEL RD.

CS 67/57-7