

GOVERNMENT CORNER RESTORATION FORM

FILED

TOWNSHIP 24S RANGE 2W SEC. 11

PMS # 600500

Date: 12/7/2023 By: J

This survey consists of:

Map: \_\_\_\_\_

Narrative: \_\_\_\_\_  
Corner Rpt: CS67/57-22

DOUGLAS COUNTY OREGON

DATE June 2023

DOUGLAS COUNTY  
SURVEYOR

Corner Designation

see COR 11/12  
14/13

Monument(s) Found: (Condition and Source)

BLM BRASS CAP  
UP 6"

Condition report

Not Found

Renewed

Unrecorded

Surveyed In

Previous Renewals

BLM RESURVEY 1968 Vol 34  
Pg 14272

HOFFINE 1999 M133-59

\* Edwards 2023 CS65/111-50  
Filed after DESO visit \*

MONUMENT DETAIL

T26S R2W

511/512

514/513

1968

Accessories Found

SAWN BURNED 20" X 4 FT D. FIR STUMP  
N46 1/2° W 24.6 FT HEALED BLAZE

SAWN BURNED 66" X 4 FT D. FIR STUMP S48 1/2° W  
32.9 FT (Rec S40 1/2° W) HEALED BLAZE

SAWN BURNED 24" X 4 1/2 FT D. FIR STUMP  
S62 1/2° E 41.5 FT HEALED BLAZE

SAWN BURNED 18" X 3 1/2 FT D. FIR STUMP  
N57° E 41.2 FT HEALED BLAZE

ALL TREE'S HAVE ROSEBURG RESOURCES TAGS  
& SPIKED TOP CENTER  
4 STEEL POST AROUND MONUMENT ONE IN  
EACH QUADRANT 2 FT AWAY

C.S. File 67/57-22

RENEWAL

Monument Set (Procedure and Description)

MONUMENT DETAIL

\_\_\_\_\_  
\_\_\_\_\_  
New Accessories

\_\_\_\_\_  
\_\_\_\_\_  
Sketch of Monument, Accessories, and General Area

Location & Comments

LAT. 43°18'49.72" N  
LONG 122°53'37.06" W

MON ON S.W. slope  
Approx 130' South  
AND 250' WEST OF  
GRAVEL ROAD

AREA BURNED  
9/2020

Comp. Decline. 14 1/2 E


Agency DCSD

Party Chief S. F. AUSE

Note keeper

Witnesses J. LORSUNG

\* Did not type - Edward's Corner report CS 65/111-50 was filed after the crew's visit, it has already been typed - A note was typed about the steel posts, the location note, declination & the lat-long information CS 67/57-22

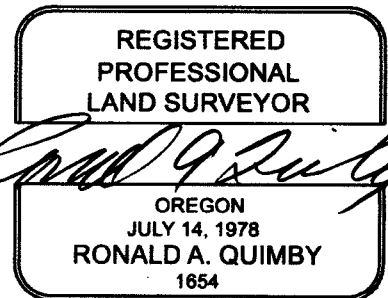

EXPIRES: 12/31/2024

MM GPS 6/15/23

TIME - 9:20

H.I. - 2.000M

TOWNSHIP 26

RANGE 02

POINT IDENTIFIER # 600500

RENEWED RFP

JUNE, 2023

PRIMARY CORNER DESCRIPTION Cor. Secs. 11, 12, 13, & 14

Alias \_\_\_\_\_ Description \_\_\_\_\_  
 Alias \_\_\_\_\_ Description \_\_\_\_\_  
 Alias \_\_\_\_\_ Description \_\_\_\_\_  
 Alias \_\_\_\_\_ Description \_\_\_\_\_

GLO survey by John A. McQuinn, Deputy Surveyor, under contract No. 466, dated April 5, 1883 - (DCSO records Vol. 10 Page(s) 4193-4)

Set post, 4 ft. long, 4" sq., 24" in the ground for cor. of secs. 11, 12, 13, & 14, mkd T26S S12 on NE, R8W S13 on SE, S14 on SW & S11 on NW faces with 4 notches on S and 1 notch on E edges, from which

- A fir, 30" dia. bears N.55°E. 19 lks. mkd: T26S R2W S12 BT
- A fir, 30" dia. bears S.30°E. 22 lks. mkd: T26S R2W S13 BT
- A fir, 40" dia. bears S.55°W. 18 lks. mkd: T26S R2W S14 BT
- A fir, 36" dia bears N.50°W., 139 lks mkd: T26S R2W S11 BT

BLM dependent resurvey by Lynn M. Roseberry, Cadastral Surveyor, Group #664, surveyed April 1968 - (DCSO records Vol. 34 Page(s) 14272)

The cor. of sees. 11, 12, 13, & 14,, determined at record dist. from the remaining original BTs:

- A fir snag, 50" dia., bears S.27°W., 18 lks., with faint evidence of bark scribing visible on remaining portion of original blaze. (Record, S.55°W.)
- A fir, 60" dia., bears N.26°W., 139 lks., with faint evidence of bark scribing visible on remaining portion of original blaze. (Record, N.50°W.)

At the corner point

Set an iron post, 28", long, 2" dia., 24" in the ground, with brass cap marked.

|      |      |
|------|------|
| T26S | R2W  |
| S 11 | S 12 |
| S 14 | S 13 |
| 1968 |      |

from which new BTS

- A fir, 12" dia., bears N.57°E., 62½ lks., mkd: T26S R2W S12 BT.
- A fir, 16" dia. bears S.64°E., 63 lks mkd: T26S R2W S13 BT
- A fir, 62" dia., bears S.51½°W., 51 lks., mkd: T26S R2W S14 BT.
- A fir, 12" dia. bears N.48°W. 38 lks. mkd: T26S R2W S11 BT

Ken Hoffine - For: Lone Rock Timber Co. - 10/1999 - M 133-59

Found - 1968 BLM brass cap.

BURNED SAWN 20"x4' STUMP  
BURNED SAWN 66"x4' STUMP

- 18" D. Fir bears N.46½°W. 24.6 ft (rec. N.46°W. 25.08 ft.) well healed face & BT tag.
- 65" D. Fir bears S.40½°W. 32.9 ft (rec S.51½°W. 33.66 ft.) well healed face & BLM tag.

continued next page

548½°W

CS 67/57-22  
3/4 1

TOWNSHIP 26 RANGE 02 POINT IDENTIFIER # 600500

PRIMARY CORNER DESCRIPTION Cor. Secs. 11, 12, 13, & 14

Alias \_\_\_\_\_ Description \_\_\_\_\_  
Alias \_\_\_\_\_ Description \_\_\_\_\_  
Alias \_\_\_\_\_ Description \_\_\_\_\_  
Alias \_\_\_\_\_ Description \_\_\_\_\_

BURNED SAW 24" x 4 1/2' STUMP

BURNED SAW 18" x 3 1/2' STUMP

D. Fir bears S. 62 1/2° E ✓ 41.5 ✓ ft (rec S. 64° E. 41.58 ft.) well healed face & BLM tag.

24" D. Fir bears N. 57° E ✓ 41.2 ✓ ft. (as per rec) well healed face & BLM tag.

Corner lies on SW slope approx. 130 ft. South & 250 ft. West of rock road.

- 4 STEEL POSTS AROUND MONUMENT  
ONE IN EACH QUADRANT 2 FT AWAY.

BC PROJECTING 6"

- ALL TREES TAGGED + TOP CENTER SPIKED
- NO RECORD BUT HAS "ROSEBURG RESOURCES" TAGS W/ INITIALS "BM".

Note: This visit was after Edward's crew's renewal (CS 65/111-50) and before it was filed. SC

CS 67/57-22<sub>2</sub>  
4/4