

GOVERNMENT CORNER RESTORATION FORM

TOWNSHIP 26S RANGE 2W SEC. 34 PLSS # 460140

FILED
Date: 12/20/2023 By: XC

DOUGLAS COUNTY OREGON

DATE 12-5-23

This survey consists of:

Map: _____

Narrative: _____

Corner Rpt: 67/57-24

Corner Designation

CE 1/16 S34

DOUGLAS COUNTY
SURVEYOR

Condition report

Not Found

Renewed

Unrecorded

Surveyed In

Monument(s) Found: (Condition and Source)

2 1/2" Alum CAP ON 1/2"
ID IRON pipe up 12"

Previous Renewals

set by Shrum 1979
M 76-54
SHAVER 2001 M 132-70

MONUMENT DETAIL

T26S R2W RE4287

CE 1/16

S34

1978

Accessories Found

Shrum

BURNED SAWN 24" X 6 FT W. R. Cedar
STUMP S23°E 7.4 FT Fully Healed
Single BLAZE ADD 3 1/2" MAG NAIL
RIGHT Side Center

Shaver

BURNED DEAD 24" Cedar N72°W 23.9 FT
PARTIALLY Healed
SINGLE BLAZE Scribering BURNED OFF
ADD 3 1/2" MAG NAIL RIGHT Side Center

Alum. Post 1 FT South

C.S. File 67/57-24

RENEWAL

Monument Set (Procedure and Description)

MONUMENT DETAIL


New Accessories

Sketch of Monument, Accessories, and General Area

Location & Comments

OCRS COORDINATE SYSTEM
Cottage Grove - Canyonville
Zone
N 157443.312
E 275036.933

MON. 13 50' ±
FROM END OF
LOGGING SPUR
AREA BURN
9/2020
Comp. Decline. 14 1/2' E
Agency DCSO
Party Chief S. F. HAUSE
Note keeper
Witnesses J. LORSUM

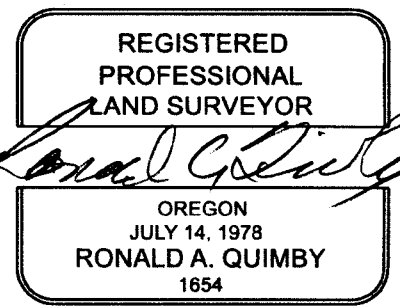

EXPIRES: 12/31/2024

CS 67/57-24
2/3

FILED

Date: 2/1/2001 By: JP

This survey consists of:

Map: M 132-70

Narrative: _____

Corner Rpt: CS 65/36-2-1

OREGON CORNER RESTORATION FORM

Section 3A Township 26S Range 2W

County Douglas Date Jan. 2A, 2001

DOUGLAS COUNTY
SURVEYOR

Corner Designation

CE 1/16

Condition Report Only

Not Found

Renewed

Unrecorded

Surveyed In

Referenced Out

Previous Renewals/Surveys, etc. _____

Tom Shrum, 1979, Map M76-56.

Monument(s) & Accessories Found: (Condition and Source)


Found 2 1/2" Alum. Cap on a 3/4" Iron Pipe, from which a:

16" Cedar BT, face overgrown, bears S73°E, 7² feet.

8" Hemlock BT, now a rotten stump, bears N37°W, 25² feet.

Monument Detail

Sketch

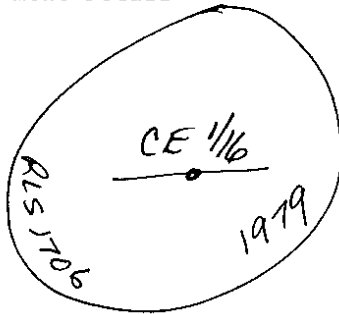

Monument Set (Procedures and Description)

None.

New Accessories

12" Cedar BT, I scribed "CE 1/16 BT", bears N70°W, 23⁹ feet.

6 Feet Alum. Post bears South, 1⁰ feet.

Location & Comments

Surveyor's Seal

Compass Declination 20°E

Firm/Agency Shaver

Engineering

Address RD. Box 1430

Roseburg, Oregon 97470

Party Chief B. Shaver

Notes " "

Witness Rev. Schneider

Gregg Danskin

REGISTERED
PROFESSIONAL
LAND SURVEYOR

Bruce A. Shaner

OREGON
OCT. 4, 1957
BRUCE A. SHANER
450

Renewed June 30,
2002

C.S. File No. 65/36-2-1