

GOVERNMENT CORNER RESTORATION FORM

FILED

TOWNSHIP 25S RANGE 2W SEC. 6 BASS # 100640

Date: 12/20/2023 By: SC

This survey consists of:

Map: _____

Narrative: _____

Corner Rpt: CS 67/57-26

DOUGLAS COUNTY
SURVEYOR

DOUGLAS COUNTY OREGON

DATE 12-11-23

Corner Designation

W 1/4 COR 56 ONLY

Monument(s) Found: (Condition and Source)

GLO 2 1/2" BRASS CAP ON
1" ID IRON PIPE
PROJECTING 12"

Previous Renewals

GLO RESURVEY 1940 VOL 27
Pgs 11518-19
McCHESNEY 1959 CS 51/112-3
EDWARDS 2013 M 165-53

___ Condition report

___ Not Found

Renewed

___ Unrecorded

___ Surveyed In

MONUMENT DETAIL

1/4 56

1943

Accessories Found

BURNED - Rotted 28" X 20' FT FIR SNA9
S40°E 1.0 FT TO HEAD OF "N" NAIL
BURNED SAWN 9" X 1 FT HEMLOCK STUMP
N 60°E 5.75 FT (REC N 80°E) EVIDENCE OF
BLAZE INSIDE ADD 3 1/2" MAG NAIL
TOP CENTER

BURNED - DEAD 11" HEMLOCK S170°E 5.9 FT
(REC S140°E) FULLY HEALED DOUBLE BLAZE
FACE BURNED OFF ADD 3 1/2" MAG NAIL
RIGHT SIDE CENTER

Reset 6 FT METAL POST 2 FT WEST

C.S. File 67/57-26

RENEWAL

Monument Set (Procedure and Description)

MONUMENT DETAIL

New Accessories

Sketch of Monument, Accessories, and General Area


Location & Comments

MON. IS at N.W COR. OF
STANDING Burnt Timber
All other Quadrants Clearcut
OCRS COORDINATE System
Cottage Grove - CANYONVILLE
ZONE

N 146408.826
E 157103.341

MON. IS APPROX
150' FT. S BUT A
OF LOGGING SPUR
ROAD

Comp. Decline. 14 1/2° E
Agency DCSO
Party Chief S. FRAUSE
Note keeper
Witnesses J. LORSUNG

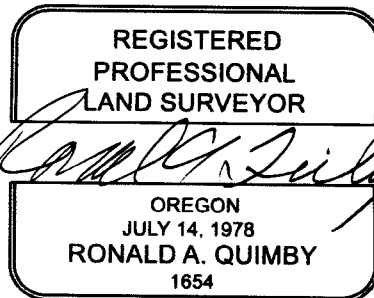

EXPIRES: 12/31/2024

CS 67/57-26
2/3

TOWNSHIP 25 RANGE 02 POINT IDENTIFIER # 100640

PRIMARY CORNER DESCRIPTION W. 1/4 Cor. for Sec. 6 only

Alias _____	Description _____
Alias _____	Description _____
Alias _____	Description _____
Alias _____	Description _____

GLO Dependent Resurvey by Norman D. Price, Under Special Instructions dated April 5, 1940 (DCSO records, Volume 27 Pages 11518-19)

Proportional measurement. Set an iron post, 3 ft. long, 1" dia., 28" in the ground, for 1/4 sec. cor. of sec. 6 only, with brass cap marked: 1/4 S6

- 1943 from which
- A Hemlock 8" dia., bears N.34°E., 20 lks. dist., mkd. 1/4 S 6 BT.
- A Fir 32" dia., bears S.40°E., 3 lks. dist., mkd. 1/4 S 6 BT.

Glen McChesney - For: Weyerhaeuser Co. - Dec. 1, 1959 - C.S. File 53/112-3

Found - 1943 Cadastral brass cap.
 8" Hemlock, now dead, face burned, no scribing visible, bears N.34°E., 13.4 ft.
 32" now 36" Fir, bark badly burned, face not opened, bears S.40°E., 1.6 ft.

Weyerhaeuser Co. July 24, 1952 visit:
 42" Fir stump, S.54°W., 20.3 ft., found notch, no "W" nail or plate.
 8" Hemlock, N.37°E., 12.5 ft., plate off.
 36" Fir BT, S.15°E., 1.0 ft. found "W" nail, plate burned off.

Accessories added this date: (1959)
 36" Fir, S.40°E., 1.0 ft. "W" nail and plate. (1943 BT)
 42" Fir stump S.51°W., 20.2 ft. "W" nail and plate. (1949 BT).

David Edwards - For: Roseburg Resources Co. - July 2013 - M165-53

RENEWED 12/11/23

PROT. MKD 2 1/2" BC ON 1" LD. I.P. RECLINATION 14 1/2° E

Found Brass cap
 36" Fir snag S.40°E., 1.0' 6"
 New STUMP 7" dia., hemlock bears N. 8° E., 5.75 ft. ADD 3 1/2" MAG NAIL TOP CNTR.
 9" dia., hemlock bears S. 15° E., 5.9 ft. ADD 3 1/2" MAG NAIL R.S.C.
 6 ft. steel post set 2 ft. N. 88° 40' 13". PHDB FACE BURNED OFF

SET FOUND METAL LATH 2 FT, WEST 17°

OCCS CANYONVILLE COTTAGE GROVE COORDS
 146408.826 N
 157103.341 E

CS 67/57-24 313

MONUMENT IS AT NW CORNER OF STANDING BURNED TIMBER, ALL OTHER QUADRANTS CLEARCUT. MONUMENT IS 150 FT SOUTH FROM LOGGING SPUR RD.

39 39

BURNED ROTTEN 28" x 20 FT
BURNED SAWN 9" x 1 FT STUMP
BURNED DEAD 11" -> 9"

GONE

TO HEAD OF "W" NAIL

EVID. OF BLZ INSIDE
ADD 3 1/2" MAG NAIL TOP CNTR.
ADD 3 1/2" MAG NAIL R.S.C.
PHDB FACE BURNED OFF