

GOVERNMENT CORNER RESTORATION FORM

TOWNSHIP 25S RANGE 3W SEC. 10 PLSS # 5009AD

FILED  
Date: 12/20/2023 By: sc  
This survey consists of:

DOUGLAS COUNTY OREGON

DATE 12-12-23

Map: \_\_\_\_\_

Narrative: \_\_\_\_\_  
Corner Rpt: CS67/57-27

DOUGLAS COUNTY  
SURVEYOR

Corner Designation

1/4 COR 10/11

Monument(s) Found: (Condition and Source)

2 1/2" GLD BRASS CAP BENT  
1 1/2 FT OF PLUM REFERENCE  
REMOVE STRIGHTEN & RESET UP 7"

Previous Renewals

GLD RESURVEY 1940 VOL 27  
Pgs 11560-61

DCSD 1966 CS 54/27-72

\_\_\_ Condition report

\_\_\_ Not Found

Renewed

\_\_\_ Unrecorded

\_\_\_ Surveyed In

MONUMENT DETAIL

1/4  
S10/S11

Accessories Found

BURNED - Rotted 40" X 3 FT FIR STUMP S 48° E  
5.3 FT FACE GONE

BURNED AWAY FIR STUMP NOW A STUB  
S35° W 34.3 FT

SAWN - SINGED 30" X 1 1/2 FT D. FIR STUMP  
N66° W 41.4 FT (REC N65° W 41.6 FT) NO BLAZE

SAWN SINGED 26" X 1 1/2 FT D. FIR STUMP  
N36° E 27.3 FT (REC 28.2 FT) FACE VISIBLE  
INSIDE

C.S. File 67/57-27

1/3

RENEWAL

Monument Set (Procedure and Description)

MONUMENT DETAIL

---



---



New Accessories

SAWN-Singed 27" X 3 FT D. FIR STUMP  
S89°E 23.5 FT 3 1/2" MAG NAIL TOP CENTER

SAWN Singed 8" X 4 1/2 FT D. FIR STUMP  
S1°W 4.3 FT 3 1/2" MAG NAIL TOP CENTER

Sketch of Monument, Accessories, and General Area


Location & Comments

DCRS COORDINATE SYSTEM  
Cottage Grove - Canyonville  
Zone

N 212711.303  
E 245448.717

AREA BURNED  
9/2020

Comp. Decline. 14 1/2° E  
Agency DCSO  
Party Chief S. F. RAUSE  
Note keeper  
Witnesses J. LORSUNG

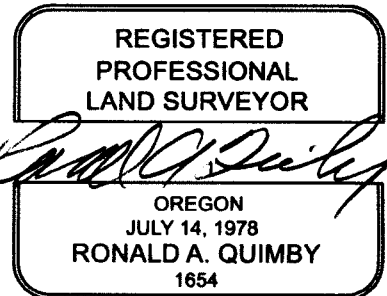

EXPIRES: 12/31/2024

CS 67/57-27 2/3

TOWNSHIP 25 RANGE 03 POINT IDENTIFIER # 500540

PRIMARY CORNER DESCRIPTION 1/4 Cor. for Secs. 10 and 11

|             |                   |
|-------------|-------------------|
| Alias _____ | Description _____ |
| Alias _____ | Description _____ |
| Alias _____ | Description _____ |
| Alias _____ | Description _____ |

Original, Laban H. Wheeler, Under Contract #467 dated April 7, 1883 (DCSO Records, Volume 9 Page 3688)

Set Cedar post 3" sq., 3 ft. long, 24" in the ground for 1/4 sec. cor. mkd. 1/4 S on W. face, from which

A Fir 30" dia., bears N.10°E., 5 lks. dist., mkd. 1/4 S BT.

A Hemlock 18" dia., bears N.19°W., 17 lks. dist., mkd. 1/4 S BT.

GLO Dependent Resurvey by Norman D. Price, Under Special Instructions dated April, 5, 1940. (DCSO records, Volume 27 Pages 11560-61)

The original 1/4 sec. cor., the badly decayed remains of a fir stake, 3 ft. long, 3" sq. on which only ax marks remain. At point for corner, Set an iron post, 3 ft. long 1" dia., 28" in the ground, with remains of fir stake deposited at the base for 1/4 sec. cor., with brass cap mkd.

*OGRS CANYONVILLE COTTAGE GROVE COORDS*

*212711.303N*

*245448.717E*

S10|S11  
1943 *2 1/2" BC*

*FOUND TILTED AND BENT SOUTHERLY  
~ 1 1/2 FT OFF FROM PLUMB PROT 12"*

Fir 60" dia., bears S.48°W., 8 lks. dist., mkd. on bark 1/4 S BT. I reblaze and remark this old bearing tree, 1/4 S11 BT.

A Hemlock 30" bears N.37°W., 20 lks. dist., with no marks remaining on face of old blaze which has been mutilated about 20 years ago. (Old BT)

A Fir 42" dia., bears S.35°W., 52 lks. dist., mkd. 1/4 S10 BT. (New BT)

*MON. PLUMB POSITION IS REFERENCED OUT  
MON. IS REMOVED AND STRAIGHTENED  
RETURNED TO REFERENCED POSITION, NOW PROT. 7" ABOVE GROUND*

*RENEWED 12/12/23*

Doug. County Surveyors Office - Vernon Tracy; Joe Brady; Jack Heritage - Aug. 1966 - C.S. File 54/27-72

*DECLINATION 14 1/2° E*

Found - GLO brass cap mkd. 1943, with steel fence post set alongside.

*VERY BURNED AND ROTTED 40" X 3 FT STUMP*

~~Orig. 60" Fir stump S.48°E., 5.8 ft. (recorded as S.48°W.), shows "BT" scribe on burned face.~~  
~~NO EVID. - Orig. 30" Hemlock stump N.37°W., 13.2 ft., burned, no scribe found.~~

*FACE GONE*

*ALMOST BURNED AWAY JUST STUBS 42"*

~~now 43" Fir S.35°W., 34.8 ft., now badly burned stump, axe marks, no scribe.~~

New BTs ~~Dv Fir N.65°W., 41.6 ft. mkd. 1/4 S10 CS BT.~~

*CORRECT AGE NO BLZ. EVID.*

~~5" Dv Fir N.36°E., 28.3 ft. mkd. 1/4 S11 CS BT.~~  
Cor. lies on top of rounded spur, sloping south.

*FACE VISIBLE INSIDE*

*NEW REFS*

*273 ft.*

*SINGED SAWN 27" X 3 FT. D. FIR STUMP, 3 1/2" MAG NAIL TOP CNTR S89°E, 235*

*SINGED SAWN 8" X 4 1/2 FT. D. FIR STUMP (MAG NAIL AS ABV.) S01°W, 43*

*156715T 21  
313*