

GOVERNMENT CORNER RESTORATION FORM

FILED

TOWNSHIP 255 RANGE 2W SEC. 6

PLSS # 100600

Date: 12/28/2023 By: X

This survey consists of:

Map: \_\_\_\_\_

DOUGLAS COUNTY OREGON

DATE 12-14-23

Narrative: \_\_\_\_\_

Corner Rpt: 67/57-28

Corner Designation

CC COR 56  
57

DOUGLAS COUNTY  
SURVEYOR

Monument(s) Found: (Condition and Source)

Condition report

2 1/2" GLD BRASS CAP

Not Found

Proj 12"

Renewed

Unrecorded

Previous Renewals

Surveyed In

GLD Resurvey 1940 Vol 27 pg 11517-18

DCSD 1966 CS 54/27-175 (CS  
54/27-168 FD)

MONUMENT DETAIL

T255

T253 | 56 CC  
R3W | 57

S12 R2W

1943

DC60 1997 CS 64/78-7

BLM Resurvey 2010-2011

Vol 57 pg 22791-2

EDWARDS 2013 M 165-53

Accessories Found

- BURNED - Rotted 27" X 5 1/2 FT FIR STUMP N 50 3/4° E  
15.2 FT BLAZE GONE
- BURNED - Rotted 27" X 6 FT FIR STUMP S 20 1/2° E  
13.4 FT (REC 13.9 FT) BLAZE GONE
- BURNED STUMP 32" X 2 FT HEMLOCK STUMP  
N 6° E 221.7 FT LOW BLAZE SCAR
- BURNED - DEAD 14" VIEW S 62 3/4° E 169.5 FT  
FRAGMENTARY Scribe VISIBLE ON PARTLY HEALED  
BLAZE ADD 3 1/2" MAG NAIL RT SIDE CENTER
- BURNED - DEAD 19" FIR N 66 3/4° E 6.3 FT (REC 6.8 FT)  
HEALED DOUBLE BLAZE ADD 3 1/2" MAG NAIL RIGHT  
SIDE CENTER
- BURNED - DEAD 13" FIR S 12 1/4° E 36.5 FT HEALED  
DOUBLE BLAZE ADD 3 1/2" MAG NAIL RIGHT  
SIDE CENTER

C.S. File 67/57-28

RENEWAL

Monument Set (Procedure and Description)

MONUMENT DETAIL

---



---



New Accessories

BURNED SAWN 12" X 3 FT Hemlock Stump  
 N 79° W 21.6 FT 3 1/2" MAG Nail Top Center

---



---



Sketch of Monument, Accessories, and General Area

Location & Comments

© CRS COORDINAT SYSTEM  
 Cottage Grove - Canyonville  
 Zone  
 N 212684.152  
 E 255396.871

MON IS IN N.W COR  
 BURNED SECOND GROWTH  
 20' EAST OF GRAVE  
 ROAD

AREA BURNED 9-2000


Comp. Decline. 14 1/2° E

Agency DCSO

Party Chief S. F. HAUSE

Note keeper

Witnesses J. LORSUMB.

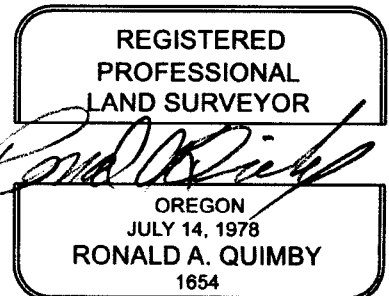

EXPIRES: 12/31/2024

CS 67/57-28

PRIMARY CORNER DESCRIPTION CC Sec 6 & 7 only (West)

Alias _____	Description _____
Alias _____	Description _____
Alias _____	Description _____
Alias _____	Description _____

8" now 10" dia. Yew, with a partially healed double blaze, scribing visible "25S R2W S7 CC CS BT", (rec. S.63°E., 168.2') 1966.

12" now 26" dia. Hemlock, with illegible scribing visible on a partially healed double blaze, (rec. N.7°E., 222.3') 1966.

New - 10" dia. D.Fir, double blazed and scribed "T25S R2W S6 CC CS BT", bears N.66½°E., 6.4'.

7" dia. D.Fir, double blazed and scribed "T25S R2W S7 CC CS BT", bears S.12½°E., 36.3'.

BLM Dependent Resurvey by A Bert Skeesick, Cadastral Surveyor Under Group No. 2317, Surveyed June 2010/June 2011 - DCSO records Vol. 57 Page(s) 22791-2

*DECLINATION 14 1/2°E 12/14/23*

The closing cor. of secs. 6 & 7 only, on the W bdy. of the Tp perpetuated by the Douglas Co. Surveyors Office in 1966, further perpetuated by the Douglas Co. Surveyors Office in 1997, monumented with an iron post, 2" dia., firmly set, projecting 12" above the ground, with brass cap (properly mkd.

from which the remains of bearing trees mkd. by Price A sawed, decayed fir stump, 36" dia., bears N.50¾°E., 15 1/2 ft., with scribe marks ~~T25S R2W S6~~ visible on fragment of a partially healed blaze. *BLZ. GONE*

*BURNED ROTTEN STUMP*

A sawed, decayed fir stump, 35" dia., bears S.20½°E., 13 1/2 ft., with scribe marks ~~T25S R2~~ visible on a partially healed blaze. *BLZ. GONE*

*BURNED ROTTEN STUMP*

and BTs mkd. by the Douglas County Surveyors Office in 1966 A hemlock, 29" dia., bears N.6°E., 221 ft., with a healed blaze. *LOW BLAZE SCAR*

*BURNED SAWN STUMP*

A yew, 17" dia., bears S.62¾°E., 169.5 ft., with fragmentary scribe marks visible on a partially healed blaze.

*BURNED DEAD*

and BTs mkd. by the Douglas County Surveyor's Office in 1997 A fir, 15" dia., bears N.66¾°E., 63 ft., with a healed double blaze.

*BURNED DEAD*

A fir, 10" dia., bears S.12¼°E., 36 ft., with a healed double blaze.

*BURNED DEAD*

Fd. as per 2011 BLM survey by D.Edwards, 7/2013 M165-53

*NEW REF*

*BURNED SAWN 12" x 3FT HEMLOCK STUMP 3 1/2" MAG NAIL TO CENTER BEARS N79°W, 216*

*MONUMENT IS IN NW CORNER BURNED SECOND GROWTH 50 FT. EAST FROM GRAVEL ROAD*  
*OCRS CANYONVILLE COTTAGE GROVE COOR.DS 212684.152 N 255396.871 E CS 6/57-28 3/3*