

GOVERNMENT CORNER RESTORATION FORM

FILED

TOWNSHIP 25S RANGE 2W SEC. 1
3w

PLSS # 100607
700600

Date: 12/28/2013 By: X
This survey consists of:

DOUGLAS COUNTY OREGON

DATE 12-14-23

Map: _____

Narrative: _____
Corner Rpt: CS 67/57-29

Corner Designation

SEC. COR 1/12

DOUGLAS COUNTY
SURVEYOR

Monument(s) Found: (Condition and Source)

2 1/2" GLO BRASS CAP
proj 12"

___ Condition report

___ Not Found

Renewed

___ Unrecorded

___ Surveyed In

Previous Renewals

GLD Resurvey 1940 Vol 27 pg 11518
DCSD 1966 CS 54/27-176
(CS 54/27-168 FD)
EDWARDS 2013 M 165-53

MONUMENT DETAIL

T25S T25S
S1 R2W
S12 S6
R3W
1943

Accessories Found

BURNED - ROTTED 36" X 4 FT FIR STUMP
S 73°W 41.2 FT FACE GONE

BURNED - SAWN 6" X 1 FT FIR STUMP BLAZE
Not Visible S 67°W 12.75 FT (REC 7.60 FT)

Singed - SAWN 14" X 1 1/2 FT FIR STUMP N 26°W
7.5 FT (REC 12.75) Scribes W S1 Visible ON
PARTIly HEATED Single BLAZE ADD 3 1/2"
WAG NAIL TOP CENTER
Note: DISTANCE TO TREE'S REVERSED

C.S. File 67/57-29

RENEWAL

Monument Set (Procedure and Description)

MONUMENT DETAIL

New Accessories

Burnt SAWN 15" X 1 FT D. FIR STUMP N49°E
14.1 FT 3 1/2" MAG NAIL Top Center

Burnt SAWN 21" X 1 FT D. FIR STUMP S71°E
15.0 FT 3 1/2" MAG NAIL Top Center

Burnt SAWN 9" X 2 FT D. FIR STUMP N68 1/2° W
4.1 FT 3 1/2" MAG NAIL Top Center

Sketch of Monument, Accessories, and General Area

Location & Comments

OUR S STATE PLANE Coordinate
System Cottage Grove -
Canyonville Zone

N 213184.782

E 255387.481

MON. IN LARGE
Burnt Clearcut +
Moderate East Slope
± 170 FT EAST OF
Logging Road

AREA Burnt 9/2020


Comp. Decline. 14 1/2° E

Agency DCSO

Party Chief S. F. Aulse

Note keeper

Witnesses J. LORSUM

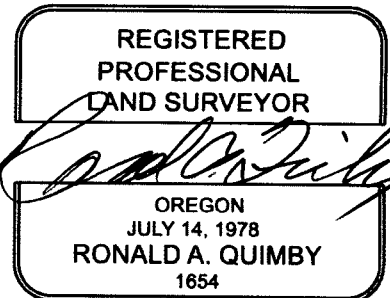

EXPIRES: 12/31/2024

CS 67/57-29

2/3

TOWNSHIP 25 RANGE 02 POINT IDENTIFIER # 100607

PRIMARY CORNER DESCRIPTION Sec. Cor. for 1 & 12 only, T25-3

Alias _____ Description _____
 Alias _____ Description _____
 Alias _____ Description _____
 Alias _____ Description _____

12/14/23

Found - GLO brass cap mkd. in 1943 with steel fence post set alongside.
 All BTs destroyed by logging. No live trees available.

Mark stumps for new BTs:

BURNED ROTTED 36" x 4 FT 40" Fir stump S.73°W., 41.2 ft. mkd. ~~T25S R3W S12 CS BT.~~ **FACE GONE**
GONE ~~43"~~ Fir stump N.71°W., 46.0 ft. mkd. T25S R3W S1 CS BT.
 This corner lies approx. 500 ft. North of closing corner of sections 6 & 7, T.25-2., in large logged off area.

David Edwards - For: Roseburg Resources Co. - July 2013 - M165-53

MOSTLY BURIED IN YUM PILE

2 1/2" GLO Found Brass cap **PROT. 12" BLAZE NOT VISIBLE**
 New ~~5"~~ Fir scribed "T25S R3W S12 BT" bears S.67°W., ~~7.60~~ **12.75**
~~12"~~ Fir scribed "T25S R3W S1 BT" bears N.26°W., ~~12.75~~ **7.5** TO **3 1/2" MAG NAIL SET TOP CNTR.**
 ✓ ft. steel post set 2 ✓ ft. north. ✓

BURNED SAWN 6" x 1 FT STUMP
SINGER SAWN 14" x 1 1/2' STUMP

OGRS CANYONVILLE COTTAGE GROVE COORD.S

DECLINATION 14 1/2° E

213184.782 N

255387.481 E

NEW REFS

BURNED SAWN D. FIR STUMP 15" x 1 FT. TALL 3 1/2" MAG NAIL TOP CNTR N49°E, 14^L FT.
 " 21" x 1 FT. TALL " S71°E, 15^L FT.
 " 9" x 2 FT. TALL " N68 1/2°W, 4^L FT.

MONUMENT IS IN LARGE BURNED CLEARCUT ON MODERAT EAST SLOPE ≈ 170 EAST FROM LOGGING RD.