

GOVERNMENT CORNER RESTORATION FORM

FILED

TOWNSHIP 25S RANGE 3W SEC. 12 PLSS # 6205A0

Date: 12/28/2023 By: X
This survey consists of:

DOUGLAS COUNTY OREGON

DATE 12-15-23

Map: _____

Narrative: _____

Corner Rpt: CS 67/57-30

Corner Designation

CW 1/4

DOUGLAS COUNTY
SURVEYOR

Monument(s) Found: (Condition and Source)

___ Condition report

___ Not Found

Renewed

___ Unrecorded

___ Surveyed In

3/4" Iron Pipe proj 9"

Previous Renewals

JULIANO 1977 M 68-32

MONUMENT DETAIL

Accessories Found

Burnt - Dead 22" D. FIR 579°E 9.8 FT (Rec
577°E 9.4 FT) ADD 3 1/2" MAG NAIL RIGHT SIDE
Center

Burnt SAWN 17" X 4 1/2 FT D. FIR STUMP
S 14°W 17.3 FT (Rec S 16°W 16.6 FT) ADD
3 1/2" MAG NAIL Top Center

C.S. File 67/57-30

13

✓

RENEWAL

Monument Set (Procedure and Description)

MONUMENT DETAIL

New Accessories

Sketch of Monument, Accessories, and General Area


Location & Comments

OCRS Coordinate System
 Cottage Grove - Canyonville
 Zone

AREA BURNT
 9/2020

N 1210382.440
 E 250870.109

Comp. Decline. 14 1/2° E
 Agency DCSD
 Party Chief S. F. Aulse
 Note keeper
 Witnesses J. LORSUNG

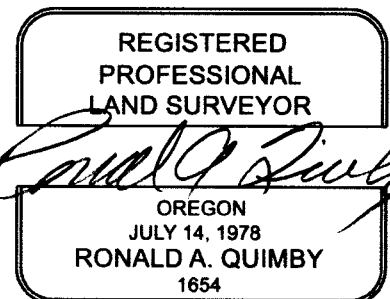

EXPIRES: 12/31/2024

CS 67/57-30

CORNERS USED FOR CONTROL

- ① **NORTHEAST SECTION CORNER**
 FOUND A GLO BRASS CAP 1943
 40" FIR STUMP, S 73 W, 41.2' CS BT
 43" FIR STUMP, N 71 W, 46.0' CS BT
- ② **EAST 1/4 CORNER SECTION 12 ONLY**
 FOUND A GLO BRASS CAP 1943
 30" FIR, S 78 W, 15.2' GLO BT
 36" FIR, S 21 W, 11.2' GLO BT
- ③ **SOUTHEAST SECTION CORNER**
 FOUND A GLO BRASS CAP 1943
 18" FIR, N 51 W, 23.0' GLO BT
 24" FIR, S 54 W, 29.0' GLO BT
 10" FIR, S 14 W, 8.6' CS BT
- ④ **SOUTH 1/4 CORNER**
 FOUND A GLO BRASS CAP UPROOTED
 UNDER A 38" FIR WINDFALL 1943
 54" FIR, N 4 W, 44.2' GLO BT
 42" FIR STUMP, S 14 W, 52.8' GLO BT
 9" DOWN HEMLOCK, S 63 W, 13.4' CS BT
 8" HEMLOCK, N 24 E, 22.7' CS BT
- ⑤ **SOUTHWEST SECTION CORNER**
 FOUND A GLO BRASS CAP 1943
 14" HEM, N 16 E, 15.5' CS BT
 30" HEM, S 53 W, 11.9' CS BT
 8" HEM, N 53 W, 20.8' CS BT
 48" FIR STUMP, N 38 1/2 W, 12.9' GLO BT,
 MK'D 11.9'
- ⑥ **WEST 1/4 CORNER**
 FOUND A GLO BRASS CAP 1943
 40" FIR STUMP, S 74 1/2 E, 29.7' GLO BT
 8" FIR, S 40 W, 19.4' CS BT
 24" CEDAR STUMP, S 67 E, 53.3' CS BT
- ⑦ **NORTHWEST SECTION CORNER**
 FOUND A GLO BRASS CAP 1943
 6" MAPLE, N 60 E, 44.4' CS BT
 15" HEM STUMP, N 8 1/2 W, 21.8' GLO BT,
 MK'D YEW STUMP

CORNERS ESTABLISHED OR RE-ESTABLISHED - CONT

- ① **SOUTHEAST 1/16 CORNER**
 SET A 3/4" X 36" IRON PIPE
 16" FIR, N 73 E, 4.6' TO R.R. SPIKE
 16" FIR, N 52 W, 13.3' TO R.R. SPIKE
 - ② **CENTER SOUTH 1/16 CORNER**
 SET A 3/4" X 36" IRON PIPE
 24" HEM, S 64 E, 22.7' TO R.R. SPIKE
 24" HEM, N 37 W, 22.5' TO R.R. SPIKE
 - ③ **SOUTHWEST 1/16 CORNER**
 SET A 3/4" X 36" IRON PIPE
 22" HEM, N 47 E, 9.6' TO R.R. SPIKE
 16" HEM, S 70 E, 10.0' TO R.R. SPIKE
 CENTER WEST 1/16 CORNER
 SET A 3/4" X 36" IRON PIPE
 22" HEM, N 47 E, 9.6' TO R.R. SPIKE
 16" HEM, S 70 E, 10.0' TO R.R. SPIKE
 CENTER 1/4 CORNER
 POINT FOR CENTER 1/4 CORNER FALLS
 ON SIDE OF ROCK BLUFF. SET A
 3/4" X 36" IRON PIPE S 87° 49 1/2" W, 7.7'
 FROM POINT FOR CENTER 1/4 CORNER
 AS A WITNESS CORNER.
 24" CEDAR, S 30 W, 10.7' TO R.R. SPIKE
 16" HEM, N 35 W, 17.7' TO R.R. SPIKE
 - ④ **CENTER EAST 1/16 CORNER**
 SET A 3/4" X 36" IRON PIPE
 48" FIR, N 1 E, 22.0' TO R.R. SPIKE
 24" HEM, S 35 W, 17.0' TO R.R. SPIKE
- RENEWED 12/15/23*
ADD 3 1/2" MAG NAIL KSC 579° E, 98 FT.
ADD 3 1/2" MAG NAIL TOP CNTR.
- BURNED DEAD 22" 8" D. FIR, S 10 E, 10.0' TO R.R. SPIKE*
BURNED SAWN 17" X 4 1/2 FT. STUMP 514° W, 17.3'
DELIMITATION 14 1/2° E
- CCRS CANYONVILLE COTTAGE GROVE COORD. S
 210382.440 N
 250870.109 E*

MAP FILE 210382.440 N 250870.109 E M68-30

NOTES

- (1) BEARINGS BASED ON GLO 1943 SURVEY FOR W 1/2 SOUTH LINE OF THIS SECTION
- (2) ● INDICATES GLO MONUMENT FOUND
- (3) ○ INDICATES MONUMENT SET
- (4) ——— INDICATES PROPERTY LINE MARKED WITH NOTCH IN BLAZE
- (5) DISTANCE TO R.R. SPIKE IN BASE OF TREE REFERS TO HEAD OF SPIKE. WEYERHAEUSER COMPANY CORNER PLATES NAILED ON ALL ESTABLISHED BEARING TREES
- (6) SCALE: 1" = 600'
- (7) SURVEYED OCT-NOV-DEC 1977 BY TRIANGLE ENGINEERING CO., EUGENE, OR. 97401
- (8) CLOSURES
 TRAV TO RE-SET N 1/4 COR 1/25,400
 TRAV TO S 1/4 AND SW CORS 1/18,500
 WEYCO PROP TRAY 1/6,700
 TRAV TO W 1/4 COR 1/20,300
 TRAV TO NW COR 1/46,500
 TRAV TO NE AND E 1/4 CORS 1/21,300

CORNERS ESTABLISHED OR RE-ESTABLISHED

- ① **NORTH 1/4 CORNER**
 SET A 3/4" X 36" IRON PIPE
 6" FIR, S 89 W, 25.5' TO R.R. SPIKE
 8" FIR, S 25 W, 37.7' TO R.R. SPIKE
- ② **SOUTH 1/16 CORNER SECTION 12 ONLY**
 SET A 3/4" X 36" IRON PIPE
 12" HEM, N 15 E, 33.4' TO R.R. SPIKE
 26" HEM, N 37 W, 14.7' TO R.R. SPIKE
- ③ **EAST 1/16 CORNER SECTIONS 12 & 13**
 SET A 3/4" X 36" IRON PIPE
 18" HEM, N 7 E, 19.6' TO R.R. SPIKE
 12" HEM, S 59 E, 5.1' TO R.R. SPIKE