

GOVERNMENT CORNER RESTORATION FORM

FILED

TOWNSHIP 25S RANGE 3W SEC. 22 PLSS # 50030D

Date: 12/26/2023 By: Y
This survey consists of:

DOUGLAS COUNTY OREGON

DATE 12-19-23

Map: _____
Narrative: _____
Corner Rpt: CS 67/57-32

Corner Designation

DOUGLAS COUNTY
SURVEYOR

Monument(s) Found: (Condition and Source)

2 1/2" GLO BRASS CAP

Condition report

Not Found

Renewed

Unrecorded

Surveyed In

Previous Renewals

GLO Resurvey 1940 Vol 27 pg 11555-56

DCSO 1966 CS 54/27-3

Smalley 1996 CS 65/8-13

BLM Resurvey 2008 Vol 57 pg:

22432-3

DCSO 2020 CS 67/046-034

MONUMENT DETAIL

T25S R3W

522/523

527/526

1943

Accessories Found

- Mostly Burned Away 20" X 2FT Cedar Stump
N 64 1/4° W 19.1 FT
- BURNED 19" X 20FT Hemlock Spag N 58 1/4° W
42.6 FT BLAZE BURNED Out.
- BURNED SAWN 8' X 6 FT FIR Stump N 62° E
23.7 FT (Rec 23.8 FT) Healed BLAZE
- BURNED DEAD 13" FIR S 46 1/2° E 22.7 FT (Rec 22.9 FT)
Healed BLAZE
- BURNED DEAD 13" D FIR N 76 1/2° W 16.7 FT (Rec
N 77 3/4° W 16.4 FT) Healed BLAZE
- BURNED SAWN 15" X 2 FT D FIR Stump S 4 1/2° W
40.7 FT (Rec 40.9 FT) Healed BLAZE
Monument orientated to South
Reference position Remove monument
Reset monument to be orientated
Correctly

C.S. File 67/57-32

RENEWAL

Monument Set (Procedure and Description)

MONUMENT DETAIL

New Accessories

Sketch of Monument, Accessories, and General Area

Location & Comments


MON. IS ON BROAD BENCH mostly
CLEARCUT TO WEST WITH
SCATTERED BURNT TREES TO
EAST

MON. IS APPROX 135'
NORTH OF LOGGING
ROAD

AREA BURNT
9/2020

LAT 43° 37.5818712
LONG - 123° 02.9653215

Comp. Decline. 14 1/2° E
Agency DCSO
Party Chief S. F. HAUSE
Note keeper
Witnesses J. LORSUNG

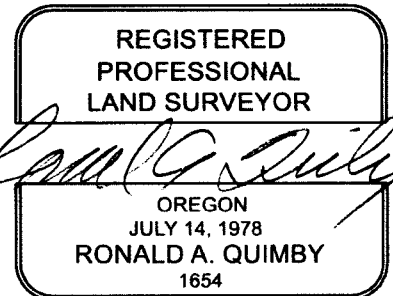

EXPIRES: 12/31/2024

CS 67/57-32

TOWNSHIP 25 RANGE 03 POINT IDENTIFIER # 500300

PRIMARY CORNER DESCRIPTION Sec. Cor. for 22, 23, 26 and 27

Alias _____ Description _____
Alias _____ Description _____
Alias _____ Description _____
Alias _____ Description _____

Doug. County Surveyors Office - Vernon Tracy; Joe Brady; Jack Heritage - June/July 1966 - C.S. File 54/27-3

Found - 1943 GLO brass cap mkd. with steel fence post alongside.
Original BTs, now snags.
12" now 16" Hemlock S.23°W., 15.8 ft. alive, nearly healed blaze. We do not open.
12" now 16" Hemlock N.21½°E., 13.2 ft., scribe visible on nearly healed blaze.
NW BT lying face down & SE BT, now burned stump.
New BTs - 16" Hemlock N.58°W., 42.9 ft. mkd. T25S R3W S22 CSBT
11" Hemlock S.43½°E., 49.1 ft. mkd. T25S R3W S26 CSBT
Cor. lies on top of spur, sloping S.61½°E.

Mark Smalley for Roseburg Forest Products, Oct. 3, 1996
C.S. File 65/8-13

Found - 1943 G.L.O. brass cap and fence post.
Accessories Found -
30" Rotted Fir stump, S.18°E., 37.0 ft.
22" Hemlock, S.22°W., 15.4 ft.; fair - healed
30" split Cedar stob, N.65°W., 18.6 ft.
16" Hemlock, N.58°W., 42.9 ft.; part. healed, scribe visible-poor
16" Hemlock, N.21½°E., 13.2 ft.; down
11" Hemlock, S.43½°E., 49.1 ft.; gone
New Accessories -
6" Fir, S.46°E., 22.9 ft. scribed "S26 BT"
6" Fir, N.79°W., 16.5 ft. scribed "S22 BT"
6" Fir, N.66°E., 24.2 ft. scribed "S23 BT"
Note - Brass cap is turned 180° from correct direction.
Corner is 130 ft. north of BLM Rd. # 25-3-36.0.

BLM Dependent resurvey by A. Bert Skeesick & Kenneth W. Saveland, Cadastral Surveyors and Robert H. Browning, Survey Tech, under Group No. 2212 surveyed July/Oct. 2008 - (DCSO records Vol. 57 Page(s) 22432-3)

The cor. of secs. 22, 23, 26, and 27, perpetuated by the Douglas County Surveyor's Office in 1966, subsequently perpetuated by Smalley, in 1996, monumented with an iron ^{2 1/2"} post, 2" dia., firmly set, projecting 20 ins. above ground, with brass cap oriented south, (properly) mkd. from which the remains of the original bearing trees
continued next page

PLUMB MONUMENT FOUND AS DESCRIBED:

POSITION IS REFERENCED OUT MONUMENT IS REMOVED FROM GROUND THEN MONUMENT IS RESET AT REFERENCE POSITION AND NOW PROT. 4 INCHES AND IS ORIENTED NORTH

12/19/23

CSL 2/57-32
314

TOWNSHIP 25 RANGE 03 POINT IDENTIFIER # 500300 12/19/23

PRIMARY CORNER DESCRIPTION Cor. Secs. 22, 23, 26, & 27

Alias _____	Description _____
Alias _____	Description _____
Alias _____	Description _____
Alias _____	Description _____

BURNED TO GROUND A ~~sawed fir stump, 38" dia., bears S.60°W., 17.8 ft., with a healed blaze.~~ ^{ROOT HOLE} ✓

MOSTLY BURNED AWAY STUMP 20" X 2 FT. A cedar, ~~29" dia., bears N.64¼°W., 19.1 ft., with no marks visible.~~ ✓

BURNED ROTTED 20" X 6 FT STUMP - OUT OF POSITION and the remaining bearing tree mkd. by Price
A hemlock snag, 20" dia., bears S.23°W., ~~15.8 ft., with a healed blaze.~~ ✓

VERY BURNED 19" X 20 FT SNAG and a BT mkd. by the Douglas County Surveyor's Office
A hemlock ✓ 19" dia., bears N.58¼°W., 42.6 ft., with a healed blaze. **BLAZE BURNED OUT** ✓

BURNED SAWN 8" X 6 FT STUMP and bearing trees mkd. by Smalley ✓
A fir, 8" dia., bears N.62°E, ~~23.8 ft with a healed blaze~~ ^{23 Z} ✓

BURNE DEAD 13" AD A fir, 10" dia., bears S.46¼°E., ~~22.9 ft., with a healed blaze.~~ ^{22 Z} ✓

BURNED DEAD 13" AD A fir, 9" dia., bears N.7¼°W., ~~16.4 ft., with a healed blaze.~~ ^{76½° 16 Z} ✓

and a new bearing tree
BURNED SAWN 15" X 2 FT STUMP A fir, 11" dia., bears S.4¼°W., ~~40.9 ft., mkd. T25S R3W S27 BT. FHSB~~ ^{40 Z} ✓

Fd. OK by DCSO: Stephen Flause & Jeff Lorsung 7-7-2020 - Orig NW BT and 1968 DCSO NW BT reported as dead - C.S. File 67/046-034 - Lat: 43.375818712 Long: -123.029653215

MONUMENT IS ON BROAD BENCH MOSTLY CLEAR CUT TO WEST WITH SCATTERED BURNED TREES TO EAST. MONUMENT IS APPROX. 135 FT. NORTH FROM LOGGING RD.

CS 62/157-32
4/4