

GOVERNMENT CORNER RESTORATION FORM

FILED

TOWNSHIP 255 RANGE 3W SEC. 28 PISS # 300240

Date: 12/29/2023 By: X

This survey consists of:

Map: _____

Narrative: _____

Corner Rpt: CS 67/57-33

DOUGLAS COUNTY OREGON

DATE 12-27-23

DOUGLAS COUNTY
SURVEYOR

Corner Designation

1/4 COR 29/28

Monument(s) Found: (Condition and Source)

Condition report

Not Found

Renewed

Unrecorded

Surveyed In

1943 GLD BRASS CAP

Previous Renewals

G2D Resurvey 1940 Vol 27 pg 11578

DCSO 1966 CS 54/27-27

DCSO 1980 CS 6/16-39

Quimby 2015 M 166-32

MONUMENT DETAIL

1/4
529 | 528

1943
Reset 1980

Accessories Found

5/8" I. Rod with Aluminum Cap stamped
B.O. IN 44" Fir Stump S83°E 44.4 FT
Rod Bent Dist to base

50" X 72" Tall Fir Stump S71°E 27.0 FT
Healed SCAR

30" Cedar S10W 78.4 FT healed SCAR

Steel Post 1 FT North

ALL remaining BTs tagged, spiked, all but the
I R Stump

C.S. File 67/57-33
114

RENEWAL

Monument Set (Procedure and Description)

MONUMENT DETAIL

New Accessories

Sketch of Monument, Accessories, and General Area


Location & Comments

OCRS COORDINATE SYSTEM
COTTAGE GROVE - CANYONVILLE
ZONE

N 194017.802
E 233981.490

AREA BURN T
9-2020

Comp. Decline. 14 1/2° E
Agency DCSO
Party Chief J LORSUNA
Note keeper _____
Witnesses _____

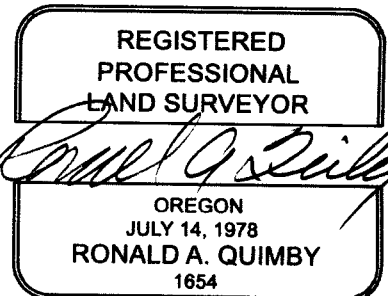

CS 67/57-33

PRIMARY CORNER DESCRIPTION 1/4 Cor Secs 28 & 29

Alias _____	Description _____
Alias _____	Description _____
Alias _____	Description _____
Alias _____	Description _____

Doug. County Surveyors Office - Ed Monrean, Deputy - T. Plouff; S. Means; S. Flause; K. Mosley - May 7, 1980 - C.S. File 61/6-39

Found - 1943 GLO brass cap on 1" I.P. protruding 0.5 ft. from ground with cap properly mkd. Cap was found bent and loosely set.

Orig. 1883 48" D.Fir now a 50" stump, bears S.71½°E., 25.8 ft. face. (Orig. rec. N.65°E., 25.1 ft., 1943 GLO rec. S.71½°E., 25.1 ft.) 27.0 ft. to center of tree. We tagged with DCSO BT tag

Orig. 60" Fir turned out and badly broken up, N.54°W., 11.2 ft. (as per 1966 rec. and orig. rec. N.70°W., 11.2 ft.) No scribing found. We tagged tree with DCSO BT tag.

22" now 24" stump, S.84½°E., 29.7 ft., shows scribing "¼ S28 BT" on unhealed single blaze. We tagged with DCSO BT tags.

32" Fir now 50" stump bearing S.3½°W., 41.6 ft. (Rec. S.5°W., per 1966. No scribing found but low cut, portion of lower blaze appears to remain. We tag tree.

20" D.Fir (Rec. 24") bearing S.31°W., 63.3 ft. (Rec. S.30°W.) mkd. "¼ S29 CS BT" partially healed double blaze, barked and capped. We tagged with DCSO tag.

26" D.Fir bearing N.38½°W., 84.1 ft. mkd. "¼ S29 CS BT" on single blazed and uprooted away from hole.

Set - Because GLO cap bent, we reference out, RESET & stamp "Reset 1980" on existing cap. Cap protrudes 0.2 ft. from ground and is firmly set.

New - Set a 5/8" I.R. with alum. cap stamped "BO" on a 44" Fir stump bearing S.83½°E., 44.4 ft. Scribed an 18" I.Cedar bearing S.1°W., 78.4 ft. Tree has a double blaze scribed "¼ S29 CS BT. We tag new B.O. stump and new tree with DCSO BT tags

Corner is now on the N-S edge of a reproduction unit.

Ron Quimby - For: Roseburg Resources - March 2015 - M166-32

Found - 1943 GLO brass cap
~~ROTTED - 36" tall, 24" stump S.84°E., 29.7'~~ partially visible scribe.

~~ROD BENT~~ - 5/8" iron rod w/aluminum cap stamped "BO" in 44" Fir
~~MEASURED TO BASE~~ stump S.83°E., 44.4'
72" tall, 50" fir stump S.71°E., 27.0' healed scar

continued next page

CS 67/57-33
3/4

