

GOVERNMENT CORNER RESTORATION FORM

FILED

TOWNSHIP 275 RANGE 6W SEC. \_\_\_\_\_

PLSS # 100/00

Date: 2/12/2024 By: [Signature]

This survey consists of: \_\_\_\_\_

Map: \_\_\_\_\_

DOUGLAS COUNTY OREGON

DATE 1-31-24

Narrative: \_\_\_\_\_  
Corner Rpt: CS 67/57-35

Corner Designation

T275  
Township Cor 536 | 531  
RTW RLW

DOUGLAS COUNTY  
SURVEYOR

Monument(s) Found: (Condition and Source)

GLD BRASS CAP  
prof 10"

\_\_\_ Condition report

\_\_\_ Not Found

Renewed

\_\_\_ Unrecorded

\_\_\_ Surveyed In

Previous Renewals

DCSO 1993 CS 64/46-9

MONUMENT DETAIL

T275  
RTW | RLW  
536 | 531  
1924

Accessories Found

Very Rotted 12" x 1 FT OAK STUMP N 84 1/2° E  
310. 2 FT No MARKS VISIBLE

40" B. OAK N 86 1/4° W 67.3 FT Fully  
healed Single BLAZE

24" W. OAK N 73 1/2° E 182.1 FT Fully  
Healed Double BLAZE

17" HALF DEAD MADRONE N 87 1/2° E 33.5 FT  
This tree to be REMOVED DUE TO  
NEW FENCE CONST.

C.S. File 67/57-35

RENEWAL

Monument Set (Procedure and Description)

MONUMENT DETAIL

\_\_\_\_\_  
\_\_\_\_\_  
New Accessories

3/8" X 30" I. ROD with DCSD yellow  
PLASTIC CAP S31°E 43.2 FT FLUSH WITH  
GROUND


5/8" X 30" I. ROD with DCSD yellow  
PLASTIC CAP S50 1/2° W 34.4 FT FLUSH  
WITH GROUND

Sketch of Monument, Accessories, and General Area

Location & Comments

\_\_\_\_\_  
\_\_\_\_\_  
\_\_\_\_\_  
\_\_\_\_\_

Comp. Decline. 14 1/2° E  
Agency DCSD  
Party Chief S. F. HUSE  
Note keeper \_\_\_\_\_  
Witnesses J. LORSUNG

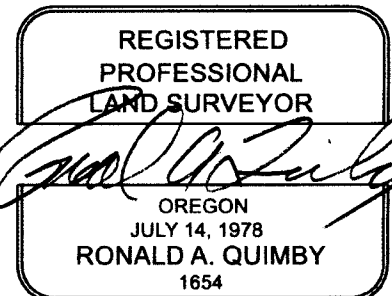

EXPIRES: 12/31/2024

CS 62/57-35  
213

TOWNSHIP 27 RANGE 06 POINT IDENTIFIER # 100100

PRIMARY CORNER DESCRIPTION SW Township Cor. T27-6

Alias _____	Description _____
Alias _____	Description _____
Alias _____	Description _____
Alias _____	Description _____

GLO survey by Elder & Gile, under Contract #31 dated April, 1853 (DCSO records, Vol. 12 Page 5151)

-----

Set post cor. to Tp. 27 S, and between Rs. 6 & 7, from which:  
 A Y.Oak 30" dia., bears N.85½°E., 560 lks. dist.  
 Made trench, no other tree near.

GLO survey by Fred Mensch, under Contract #109 dated 1924 (DCSO records, Volume 14 Page 5837)

-----

The cor. of T27S Rs. 6 & 7 W. established by Elder & Gile in 1853, is located by record bearing and distance from the original bearing tree. This tree is now hollow with an opening at the back, through which the scribe marks are visible on the overgrowth. Co. point falls in very old fence line. At the exact cor. point, Set an Iron post, 3 ft. long 3" dia., 26" in the ground, with brass cap marked:

T 27 S  
 R 7 W | R 6 W  
 S 36 | S 31  
 -----  
 1924

from which (new bearing trees)  
 A W.Oak 14" dia., bears N.84½°E., 470 lks., mkd. T27S R6W S31 BT.  
 A B.Oak 14" dia., bears N.86¼°W., 102 lks., mkd. T27S R7W S36 BT.  
 The original bearing tree, a B.Oak 40" dia., bears N.85°E., 560 lks.

*RENEWED 1/31/24*

Douglas Co. Surveyors Office - Randall W. Smith, Stephen J. Flauser; June 15, 1993 - C.S. File 64/46-9 *DECLINATION 14½°E*

-----

Found *FOUND AS DESCRIBED* 3" dia Brass Cap on a 3" dia IP protruding 10" above ground.

*THIS TREE IS DOWN NOT SEEN OR CHECKED IN THICK BRAMBLES AND POISON OAK NOW VERY ROTTED* 30" ~~now 40"~~ dia. B.Oak with rotted out center, possible blaze no scribing visible, bears N.86°E., 369.6 ft. (orig. rec. N.85½°E., 369.6 ft.) (orig. BT.)

*NOW 40* 14" ~~now 12"~~ dia. 1 ft. high Oak stump, no blazes or scribing visible, bears N.84½°E., 310.2 ft. (Mensch 1924)

*NOW 24* 14" ~~now 34"~~ dia. B.Oak with a fully healed single blaze, bears N.86¼°W., 67.3 ft. (Mensch 1924)

*NOW 24* 15" dia. W.Oak, double blazed and scribed "T27S R6W S31 CS BT" bears N.73¼°E., 182 ft. *FHDB*

*PLACED TO BE REMOVED* 17" 16" dia. Madrone, bark scribed "T27S R6W S31 CS BT" bears N.87¼°E., 33.5 ft.

cont.

*THIS TREE IS DOWN NOT SEEN OR CHECKED IN THICK BRAMBLES AND POISON OAK NOW VERY ROTTED*

*NOW 40*

*NOW 24*

*PLACED TO BE REMOVED*

*NEW REFS*

*5/8" X 30" I.R. / YELLOW DCSO PLSTC CAP FLUSH/GROUND S31°E, 432*

*" " " " S50½°W, 364*

*53-15/20 57*  
*GLE*